


16-65
C. House

59-91

Survey for
Lina Gietlhuber
1508 Oak St.
La Grande, Oregon

Date July 14, 1965

Description: Lot #3 of Block 8 of Wisdom's Addition
to La Grande, Oregon.

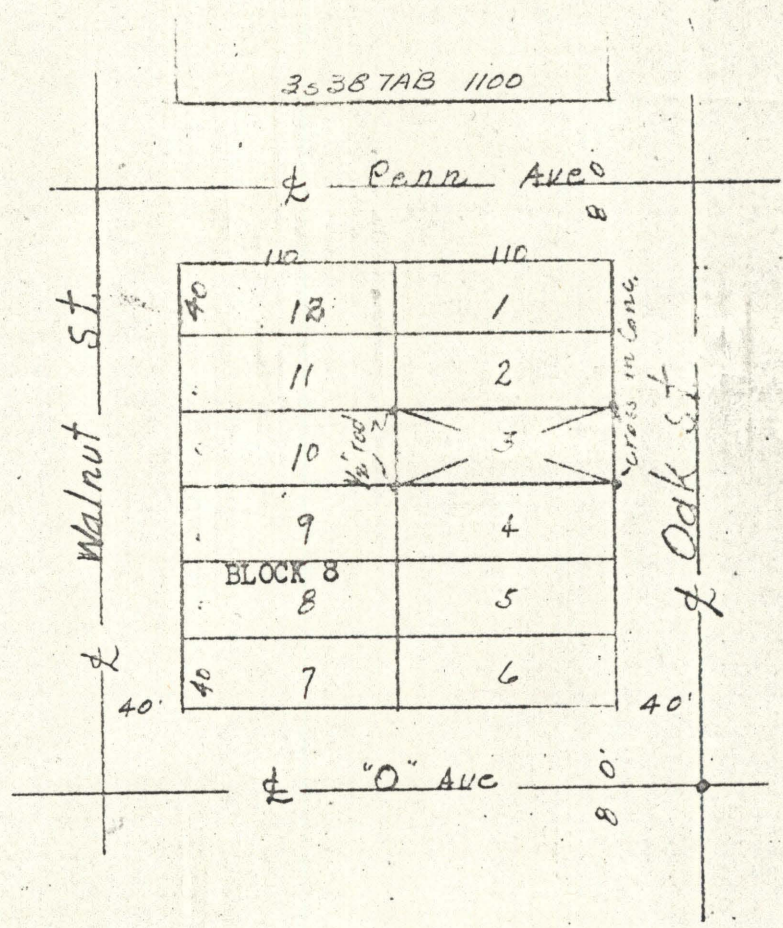

Scale 1" = 100'

REGISTERED
OREGON
LAND SURVEYOR

James G. Voelz

MAY 4, 1956
JAMES G. VOELZ
381