


19-65

19-65

*James H. [unclear]*

1 1/2" pipe found in place

Scale 1" = 600'

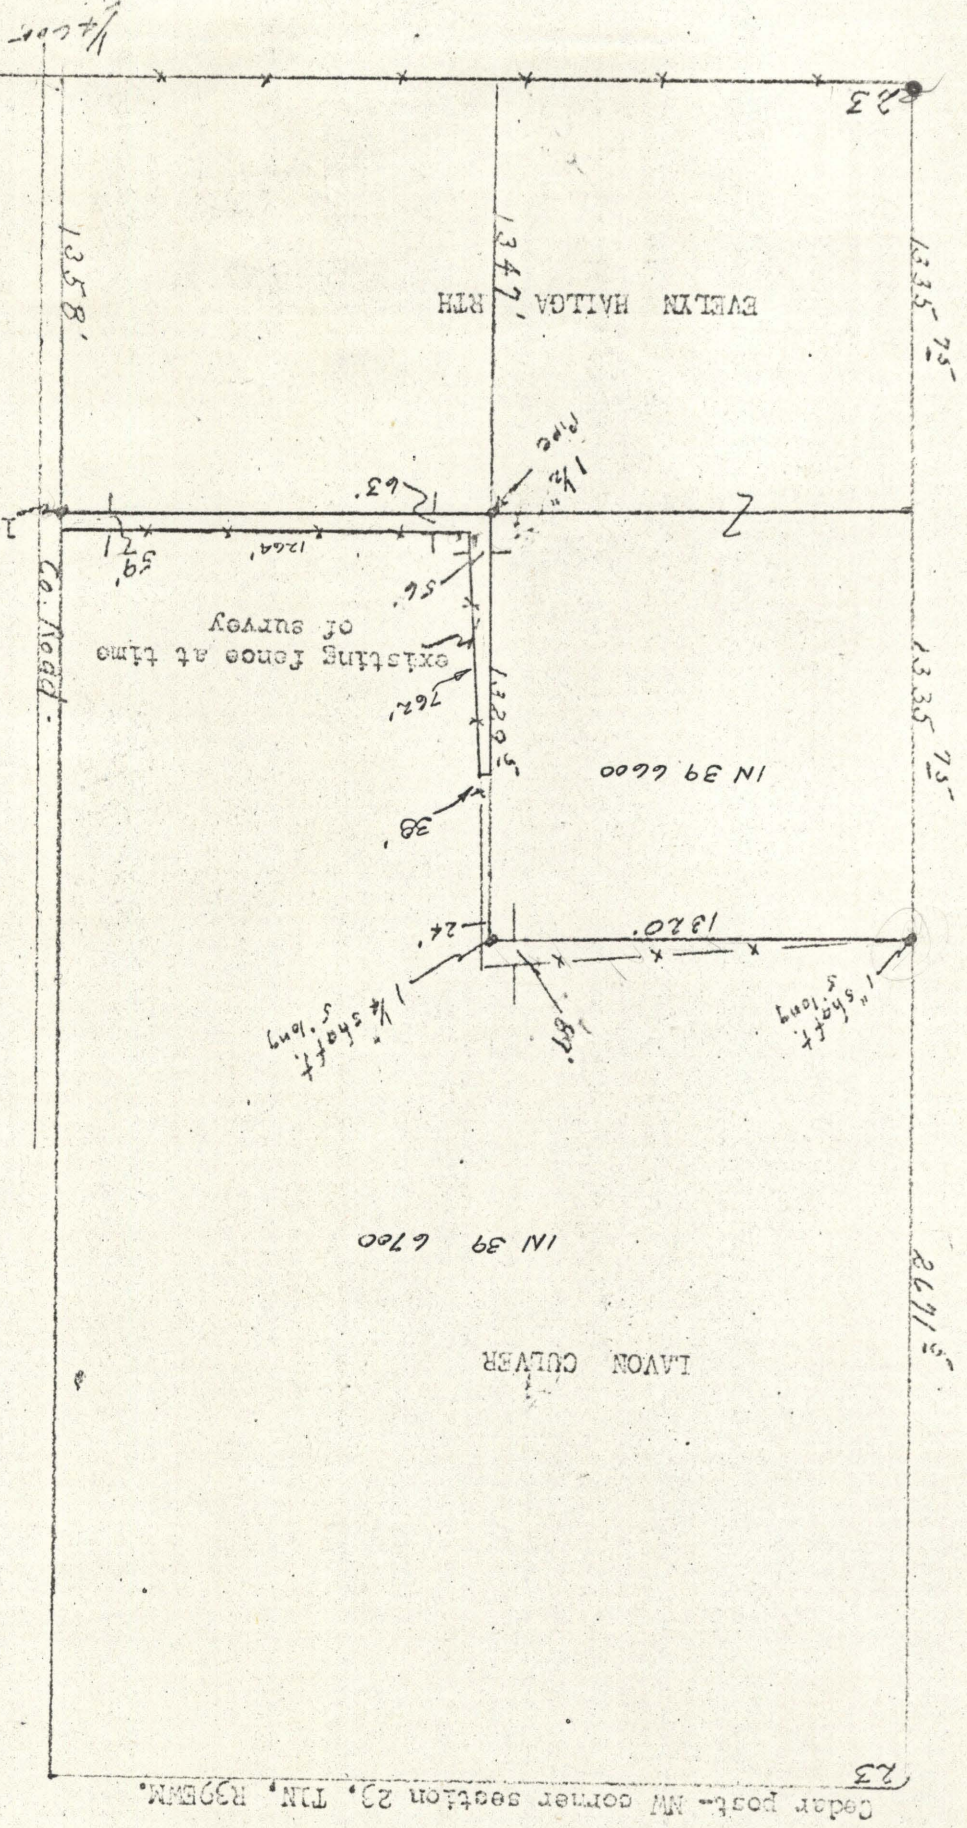

April, 8, 1965

Survey for  
Lavon Culver  
Elin, Oregon

19-65