


23-65

Survey for James Mc Farland  
Box 432, Elgin, Oregon

May 1-1965

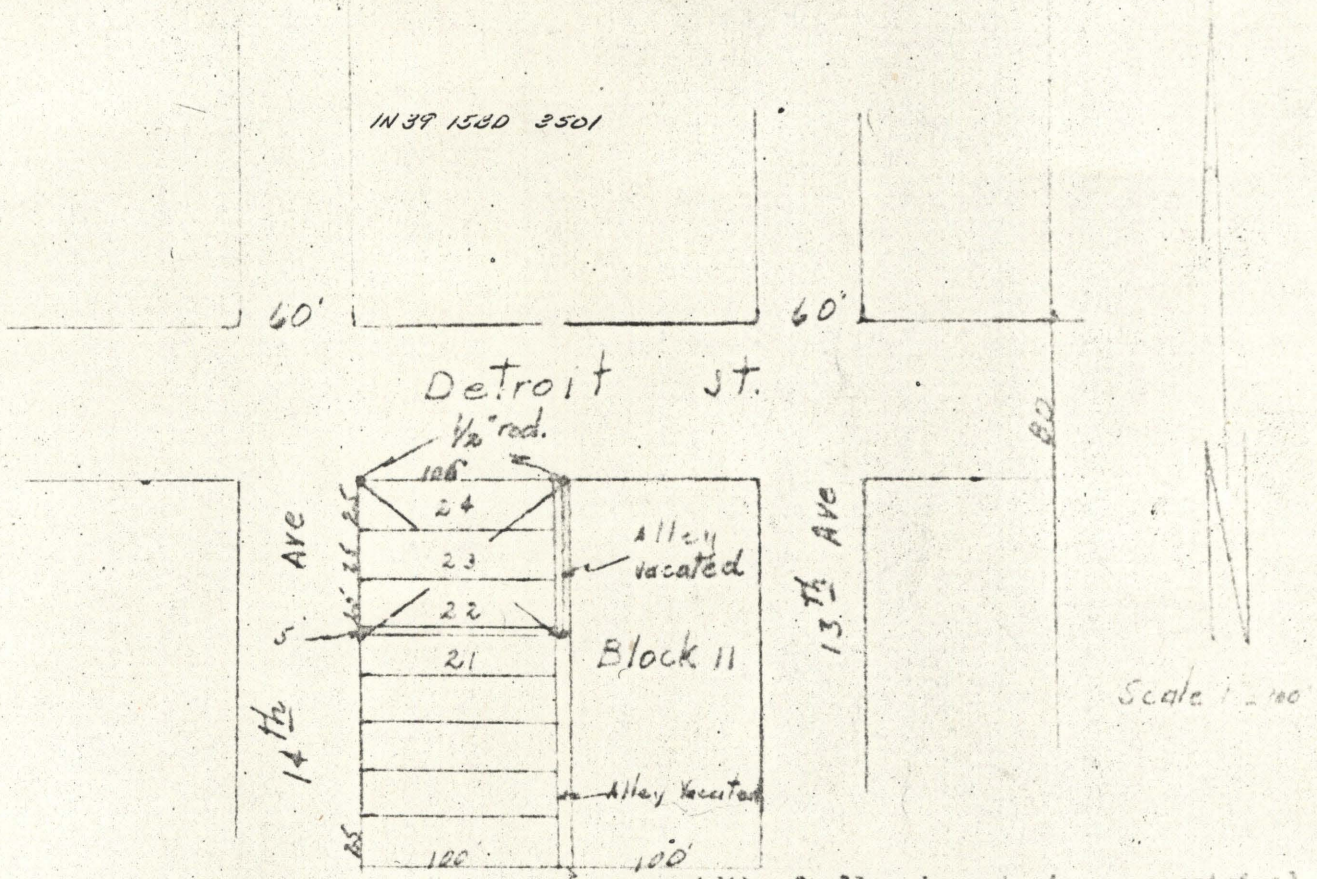

Description: Lots 24, 23, 22, and North 5 feet of lot 21 of Block 11, of North Elgin subdivision of Elgin, Oregon. Also one half (6 feet) of vacated alley of said Block 11 adjacent to described lots.

REGISTERED  
OREGON  
LAND SURVEYOR  
*James G. Vortt*  
MAY 4, 1965  
JAMES G. VORTT  
381