


26-65

59-92

Survey for
Case Brothers and John Schroeder
and Bob Gulzov.

Date April 9 to 12, 1965

2s 38

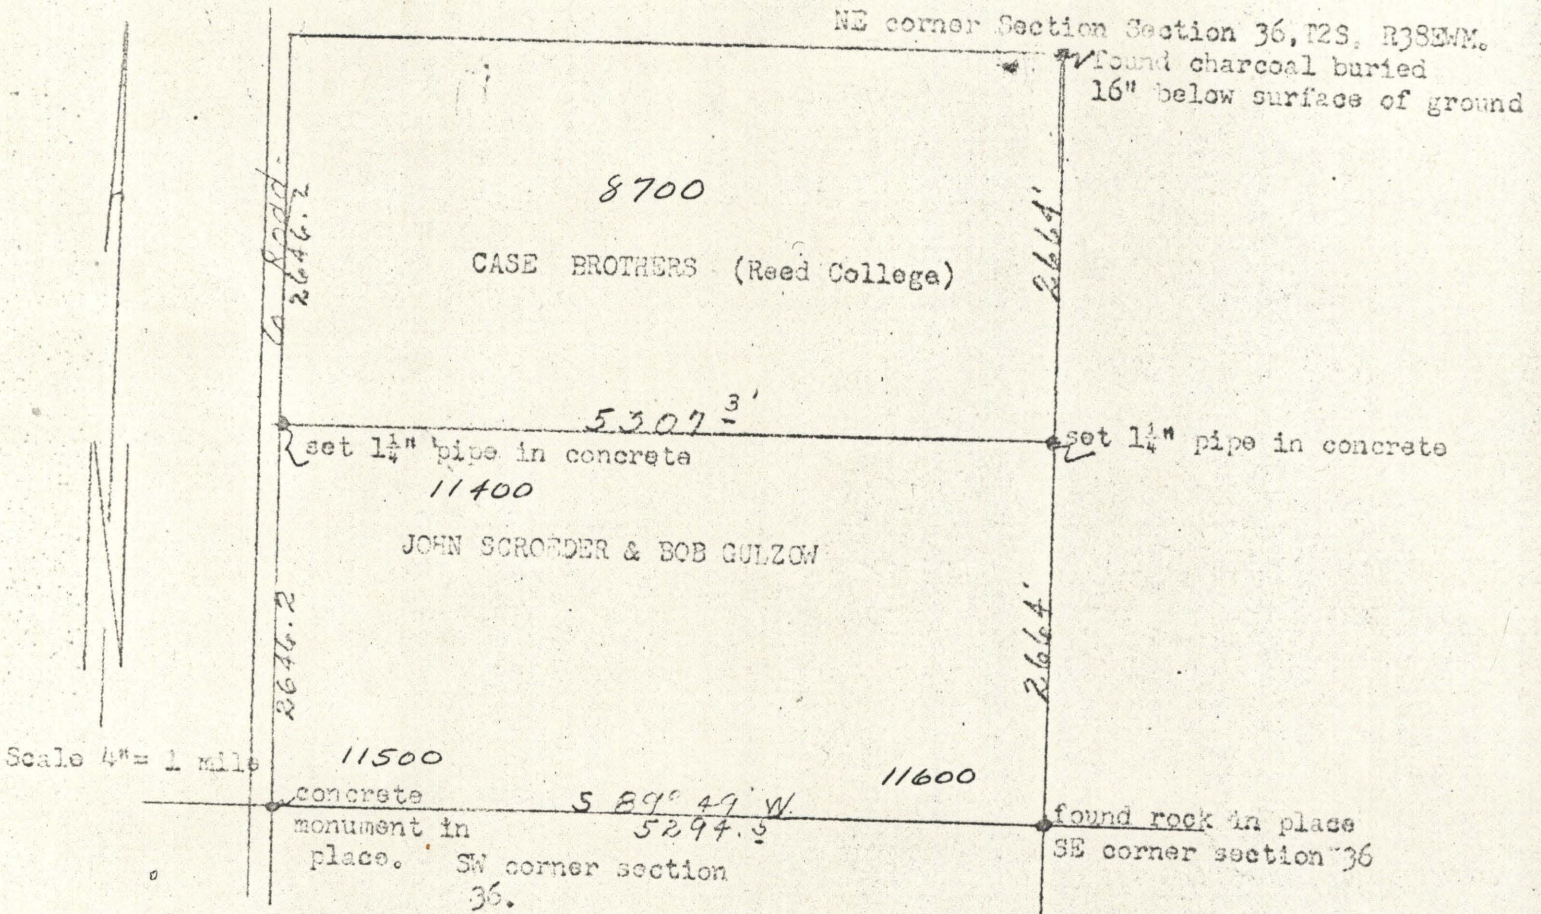

JAMES C. DAILY
 SURVEYOR
 1915
 2015