59-DE

Survey for
Nathan Mckay Smith
1102 "I"
La Grande, Oregon

Date August 9, 1965

Legal Description:
Lot 1 of Block 32 of Chaplin's Addition to La Grande, Oregon

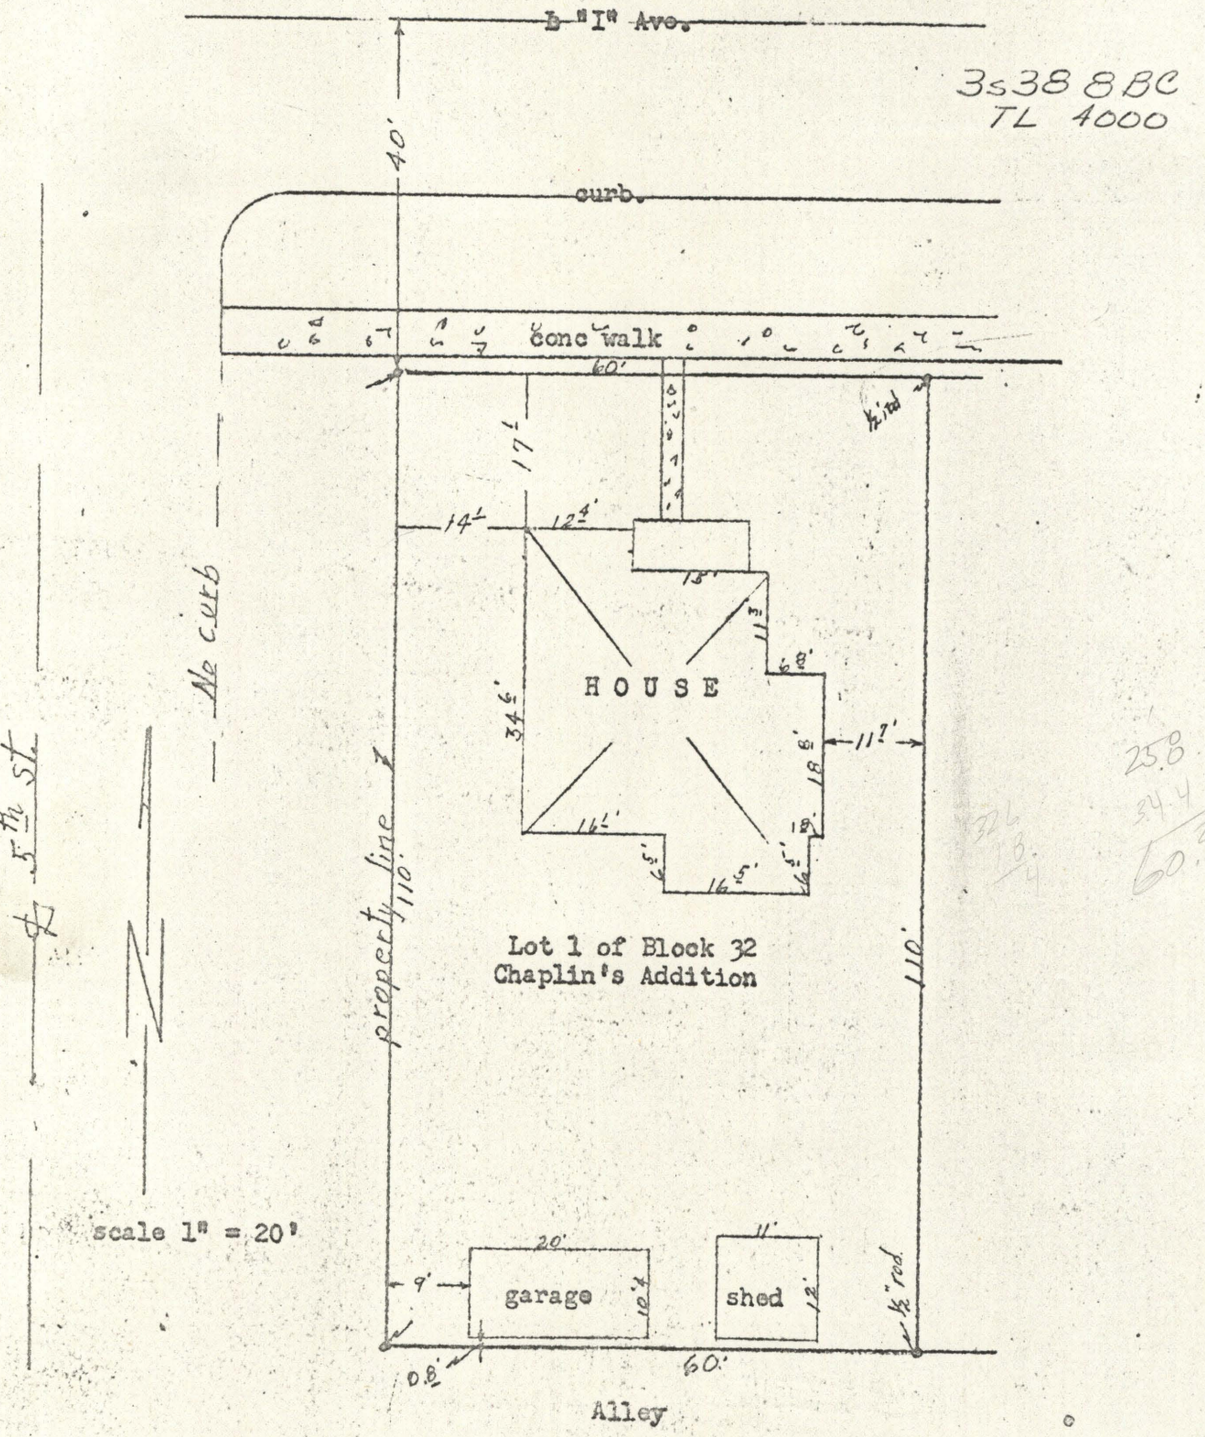

I certify this survey was completed by me on August 9, 1965 and there are no encroachments from adjoining property on to described property, nor does surveyed property extend on to adjacent property.

REGISTERED
OREGON
LAND SURVEYOR
James G. Voelz
MAY 4, 1966
JAMES G. VOELZ
981