

59-15


Survey for  
Henry F. Taylor  
Mill Canyon Road  
La Grande, Oregon

Date Sept. 24, 1965

Scale 1" = 100'

Description: Lots 3 and 4 of Block 7 of  
Arnold's Addition to La Grande, Oregon  
and alley as vacated between lots 3, 4  
and 5, 6 of Block 7 of Said Addition.

35387DA  
TL 8400

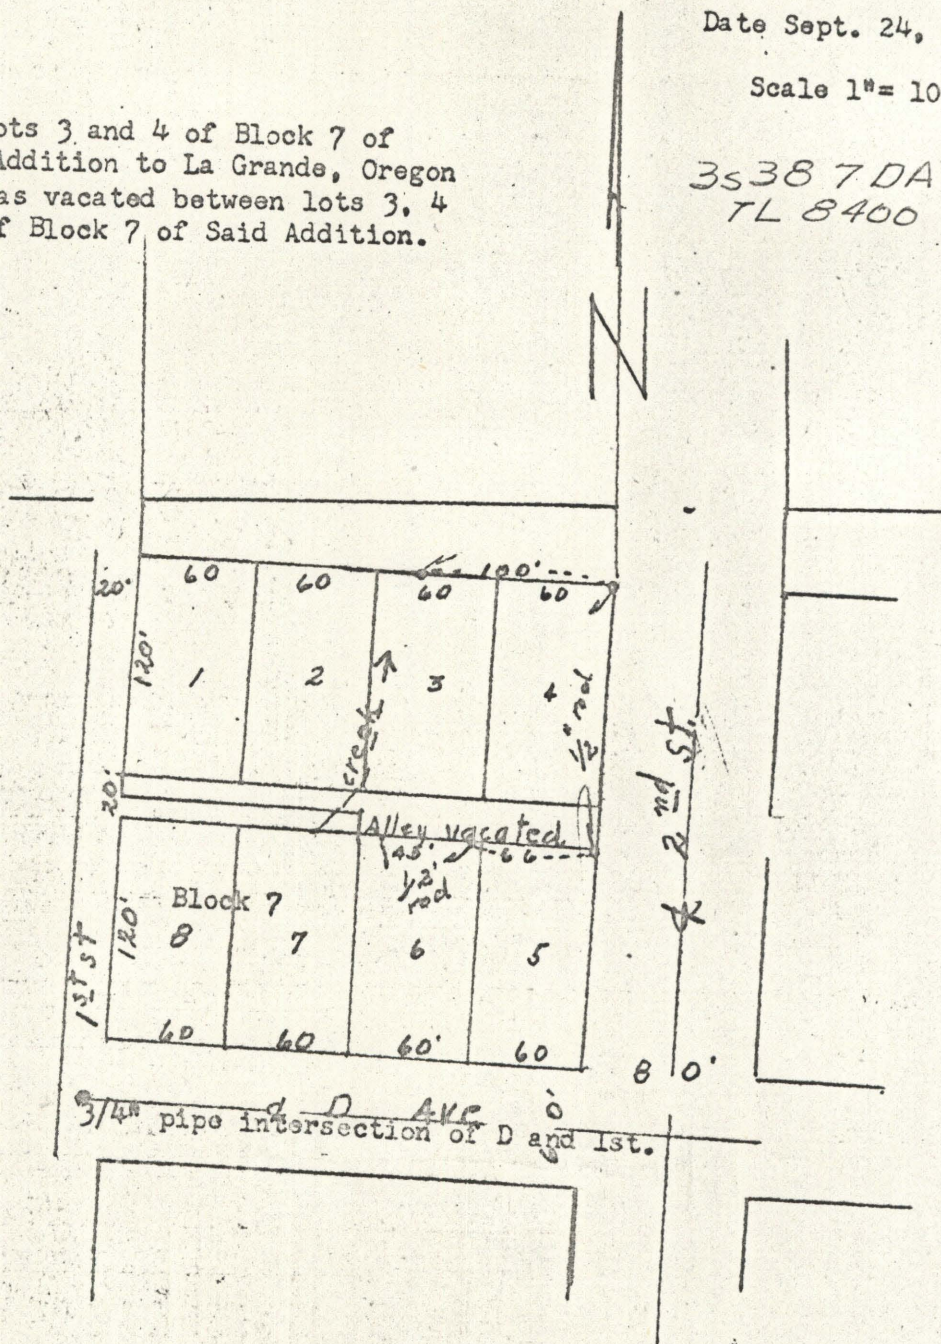

REGISTERED  
OREGON  
LAND SURVEYOR  
*James G. Vold*  
MAY 4 1918  
JAMES G. VOLD  
391

SURVEY # 31-65