


Description Lots 3, 4, and 5 of Block 1 of Carr's Sub-division to La Grande, Oregon

Date Sept. 22-23, 1965

Scale 1" = 100'
TLs 1700, 1800, 1900

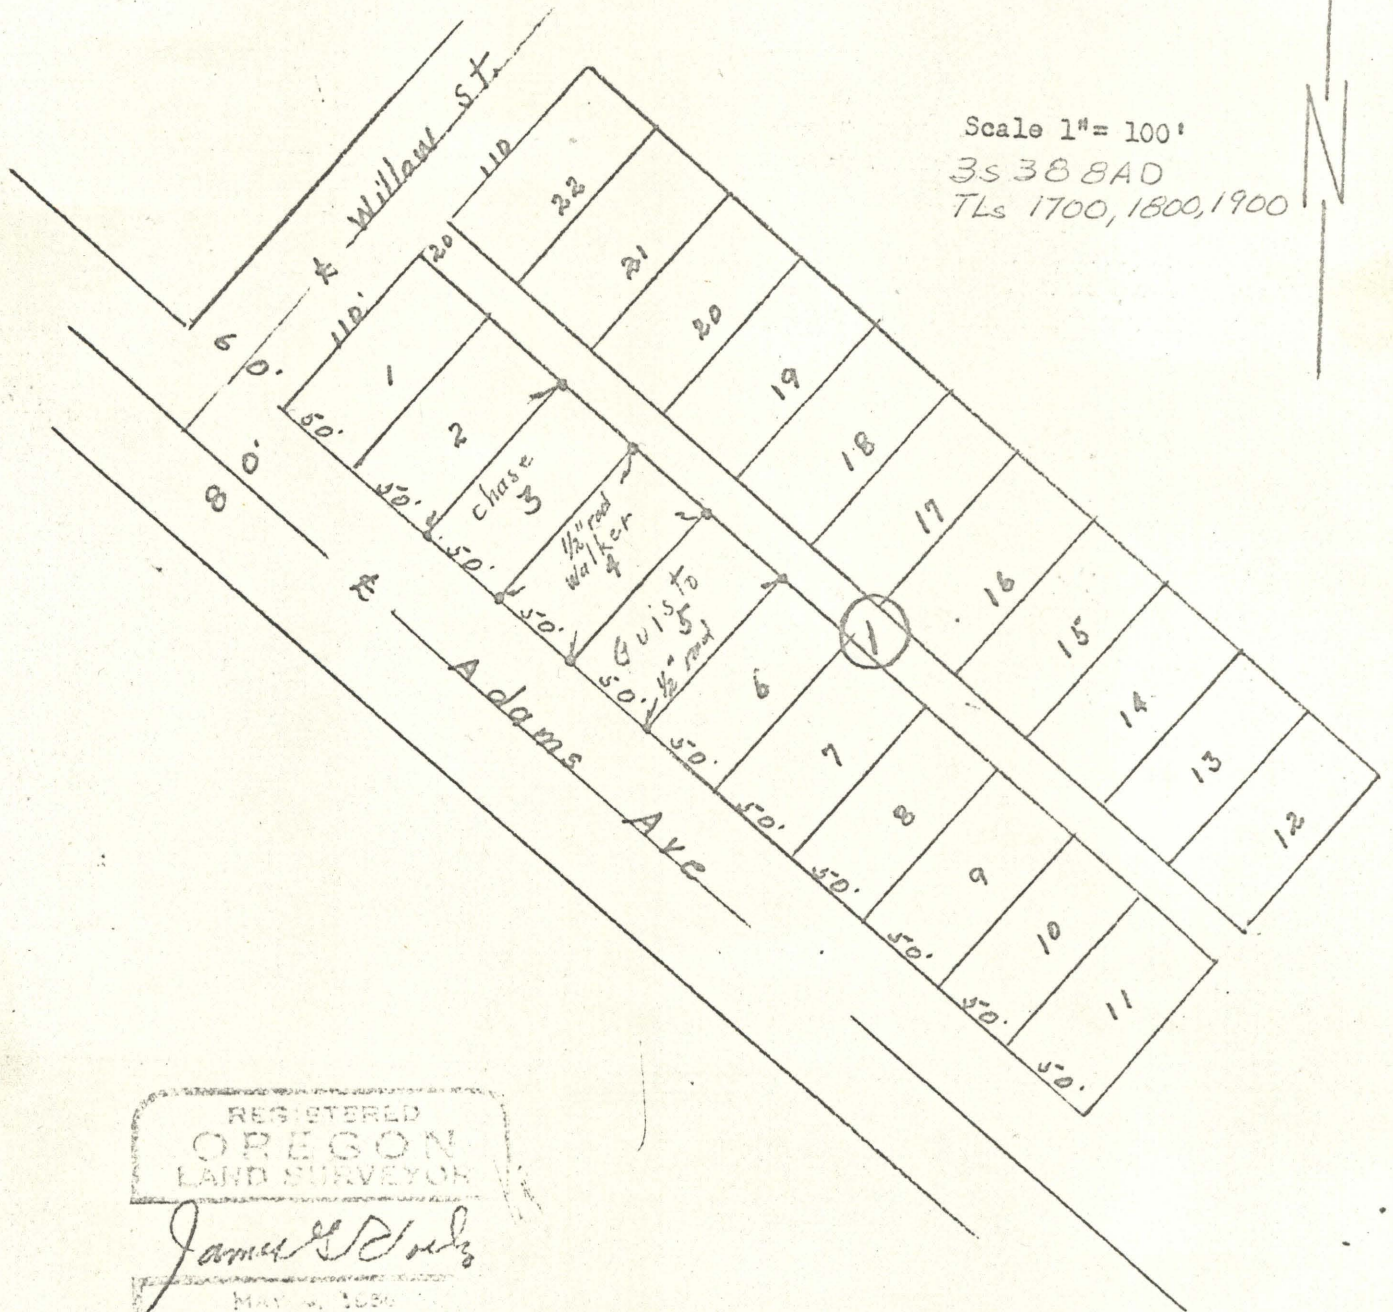

REGISTERED
OREGON
 LAND SURVEYOR

James S. Boyd

MAY 11 1966
 JAMES S. BOYD
 391