

SURVEY No. 33-65

3365



Survey for
Mr. & Mrs Paul Edgerton
La Grande, Oregon

3s 386DC
16200

Date August 2, 1965

Legal Description;

Lots 3&4 of Block 1 of Bavaria Addition to La Grande, Oregon.
Also beginning at south west corner of lot 4 of Block 1 of said
addition; Thence west 38 feet; Thence north 80 feet; Thence east
38 feet; Thence south 80 feet to point of beginning.
Excepting from the above description the east 10 feet of lots
3&4 of Block 1 of said addition.

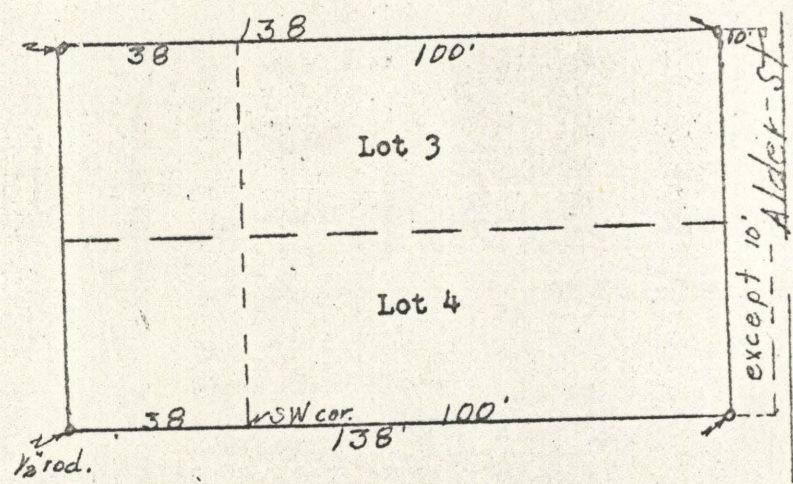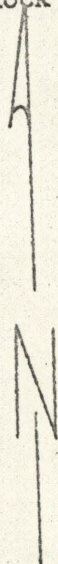

Scale 1" = 40'

REGISTERED
OREGON
LAND SURVEYOR

James G. Voelz

MAY 2, 1966
JAMES G. VOELZ
381