35-65

57-55

Survey for
Lee M. & Ruth L. Lafferty
803 Grandy Ave.
La Grande, Oregon

Date June 17, 1965

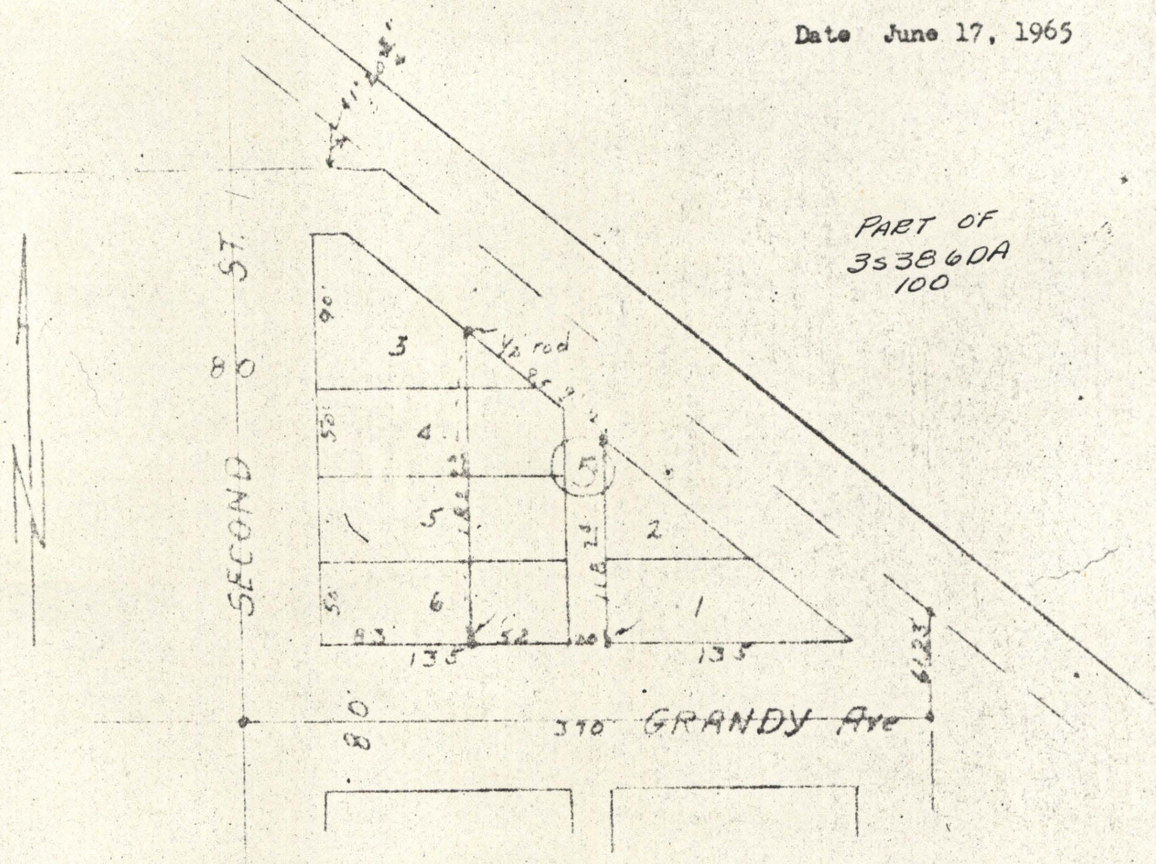

Description; The east 52 feet of lots 3, 4, 5, and 6 of Block 5 to Grandy's Addition to La Grande, Oregon. Also the alley (20') adjacent to described property to become a part of said property at termination of vacation proceedings.

REGISTERED
OREGON
LAND SURVEYOR
James G. Voelz
MAY 4, 1956
JAMES G. VOELZ
381