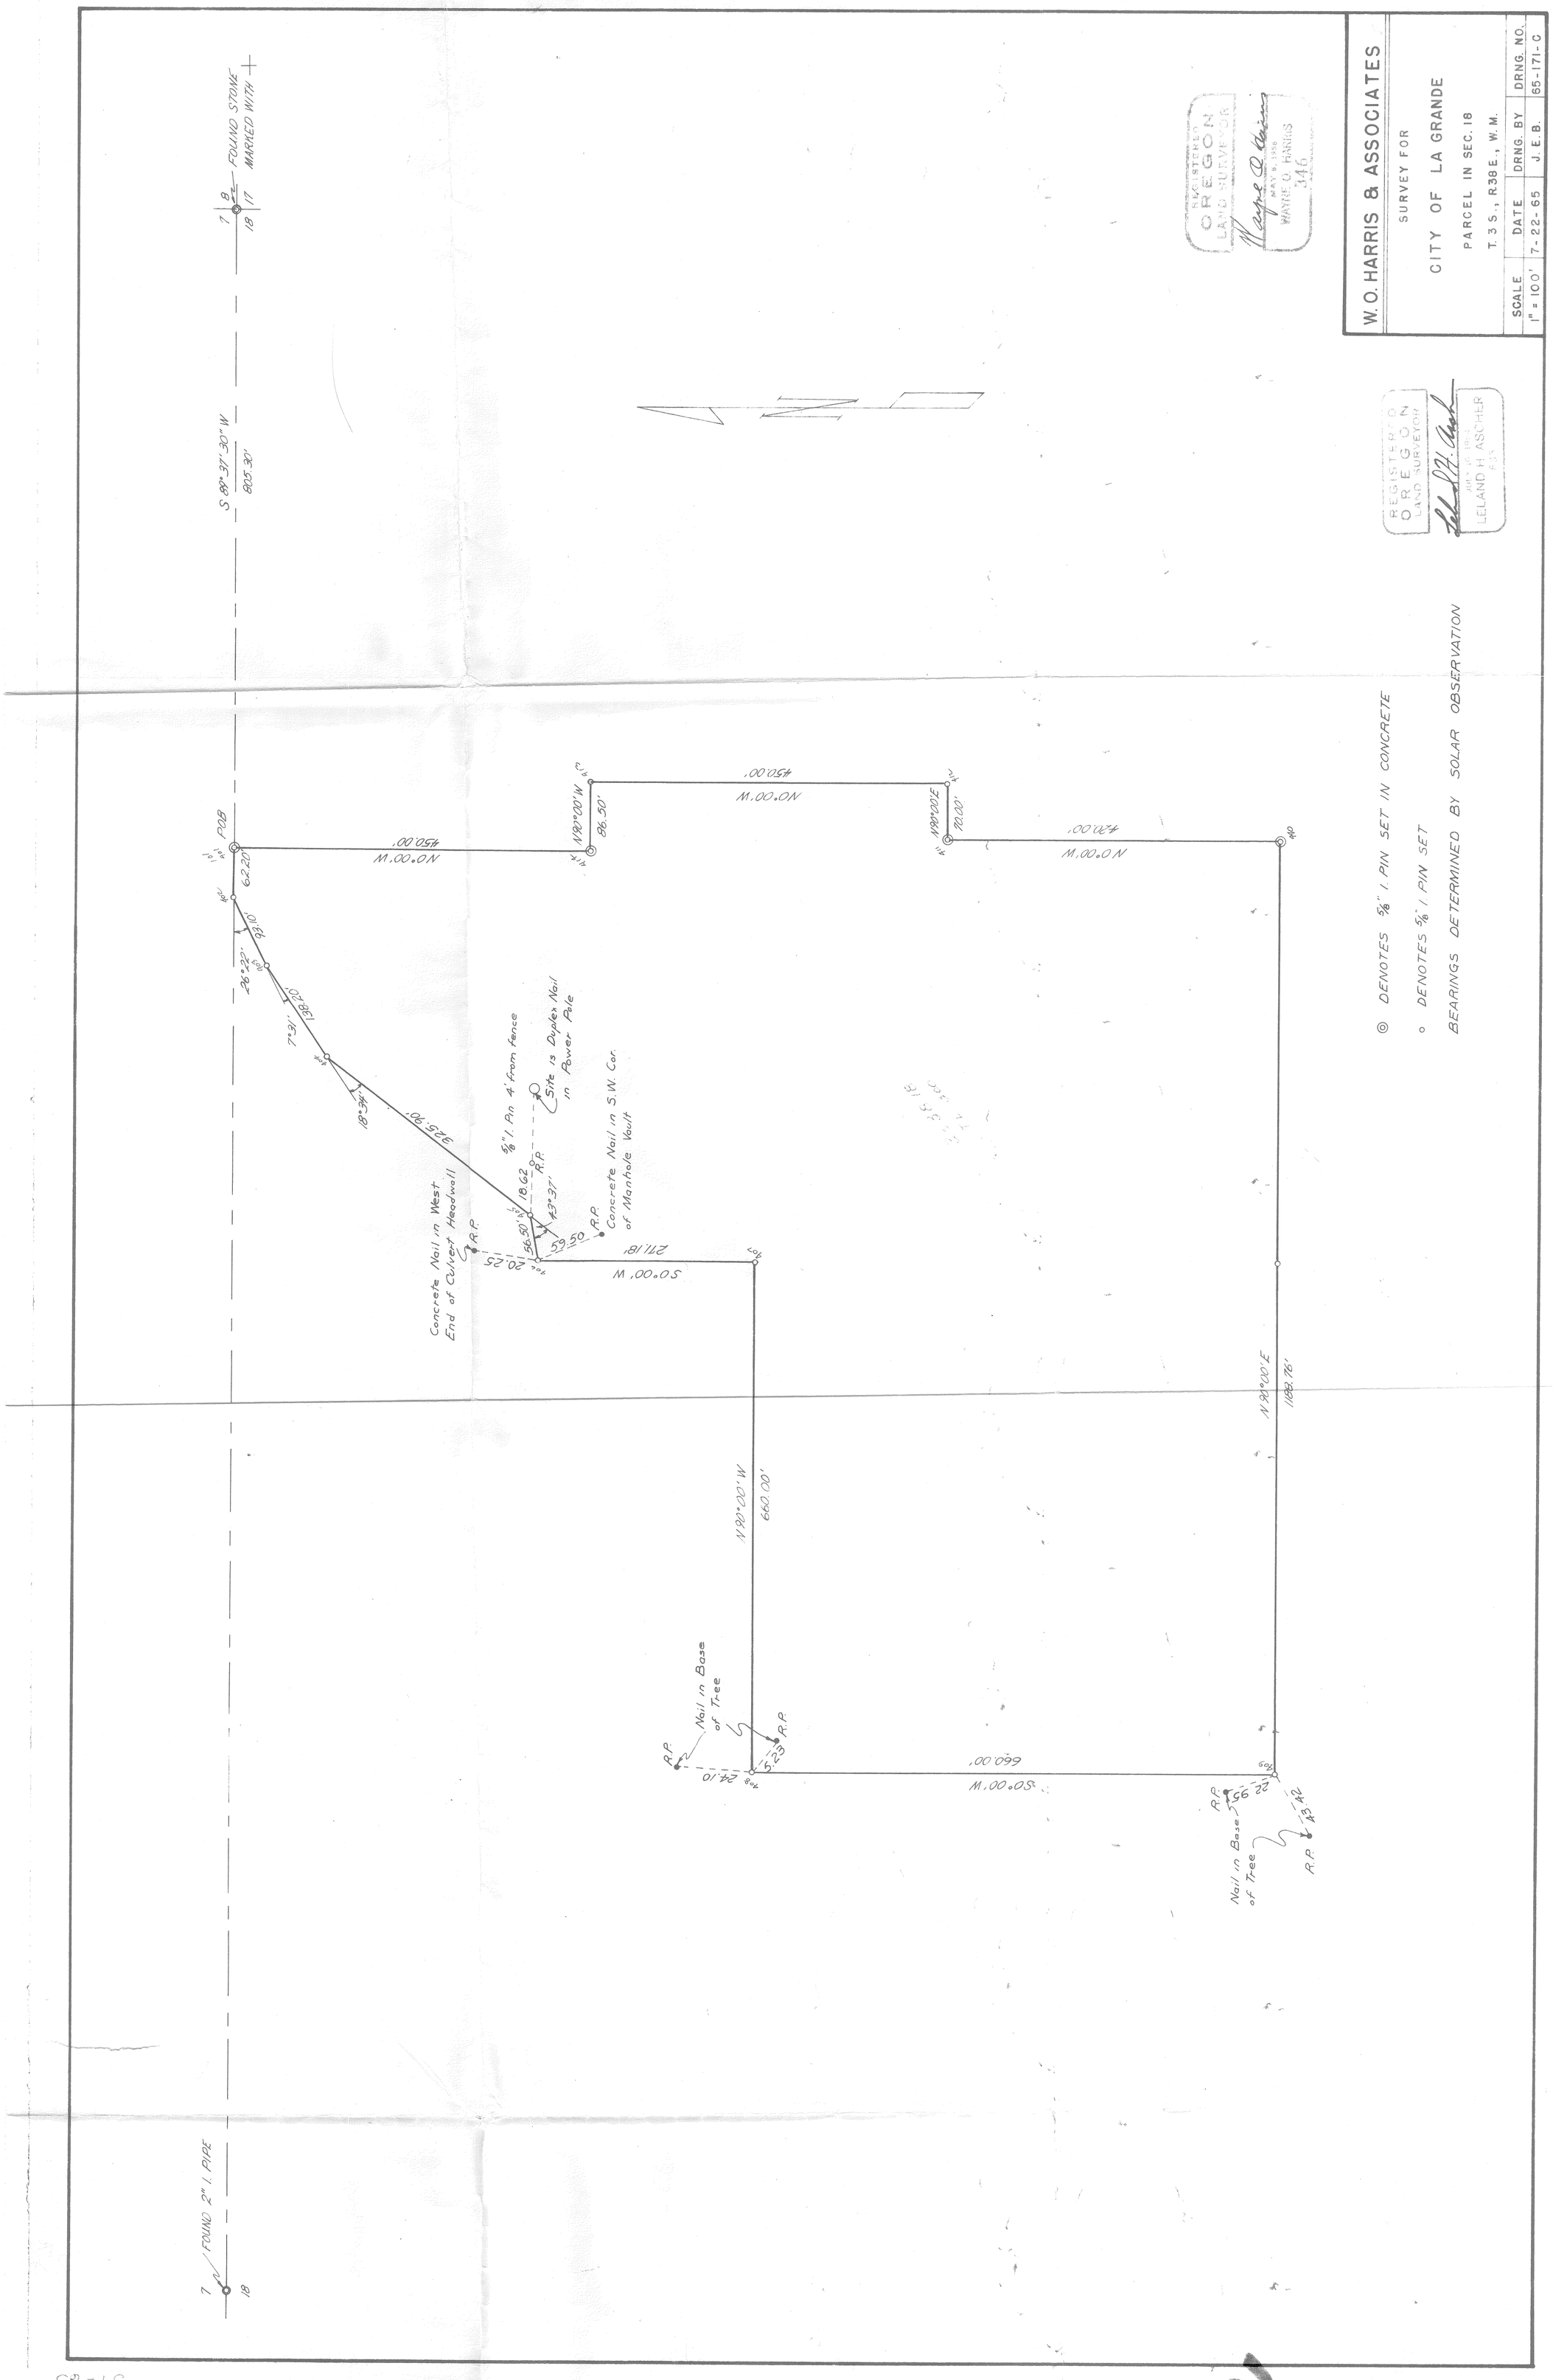
W. O. HARRIS & ASSOCIATES
SURVEY FOR
CITY OF LA GRANDE
PARCEL IN SEC. 18
T. 3 S., R. 38 E., W. M.
SCALE 1" = 100'
DATE 7-22-65
DRNG. BY J. E. B.
DRNG. NO. 65-171-C
REGISTERED OREGON LAND SURVEYOR
MAY 6, 1956 WAYNE O. HARRIS 346
REGISTERED OREGON LAND SURVEYOR
JULY 10, 1954 LELAND H. ASCHER
◎ DENOTES 5/8" I. PIN SET IN CONCRETE
○ DENOTES 5/8" I. PIN SET
BEARINGS DETERMINED BY SOLAR OBSERVATION
FOUND STONE MARKED WITH +
S 89°37'30" W
805.30'
FOUND 2" I. PIPE
POB
N 90°00' W
660.00'
N 90°00' E
1188.76'
S 0°00' W
271.18'
Concrete Nail in West End of Culvert Headwall
Concrete Nail in S.W. Cor. of Manhole Vault
5/8" I. Pin 4' from fence
Site is Duplex Nail in Power Pole
Nail in Base of Tree
R.P.
37-65
37-65
37-65