

40-65
V


40-65

Survey for
Mrs. Mary Hermann
1403 Walnut St.
La Grande, Oregon

35387AB
4501

Oct. 16, 1965

Description: The west 93 ft. of Lot 7 and the south 24 ft. of west 93 ft. of Lot 6 of Block 7 of Wisdom's Addition to La Grande, Oregon.

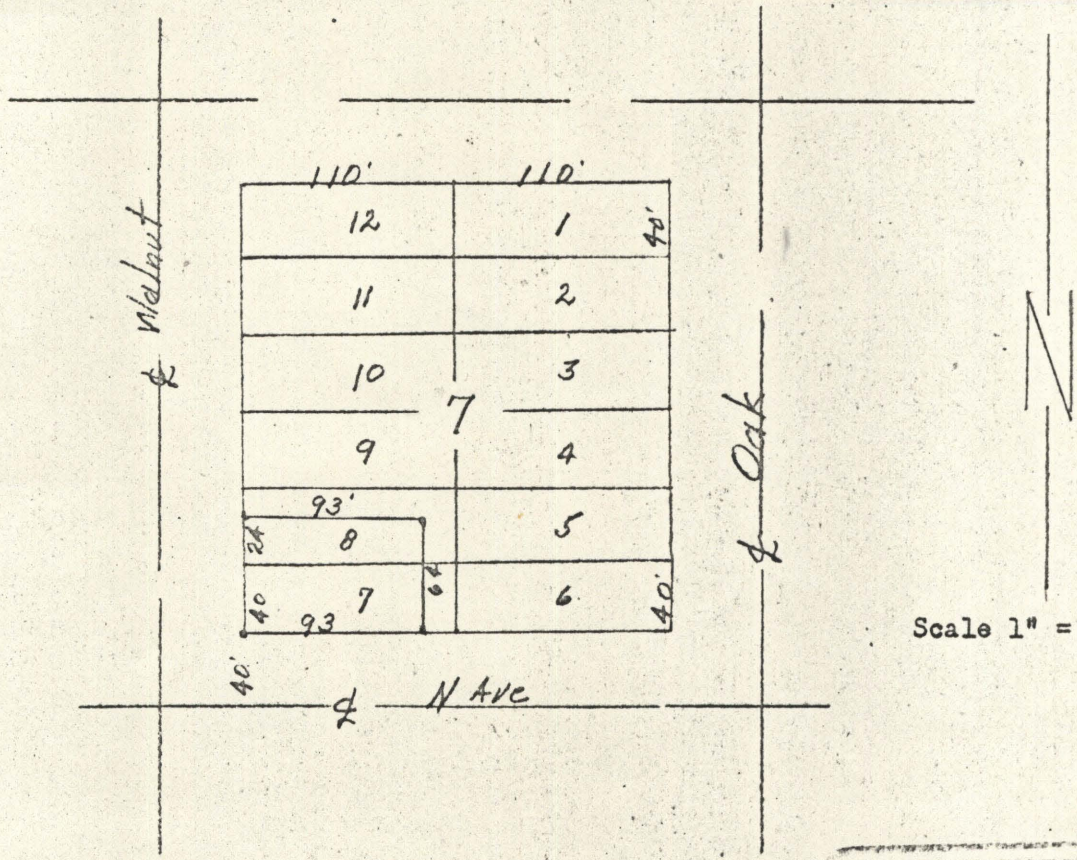

Scale 1" = 100'

REGISTERED
OREGON
LAND SURVEYOR
James G. Volle
MAY 6, 1965
JAMES G. VOLLE
281