


43-65

Survey for
Ralph G. Peinecke
Sunset Drive
La Grande, Oregon

Date Oct. 7, 1965

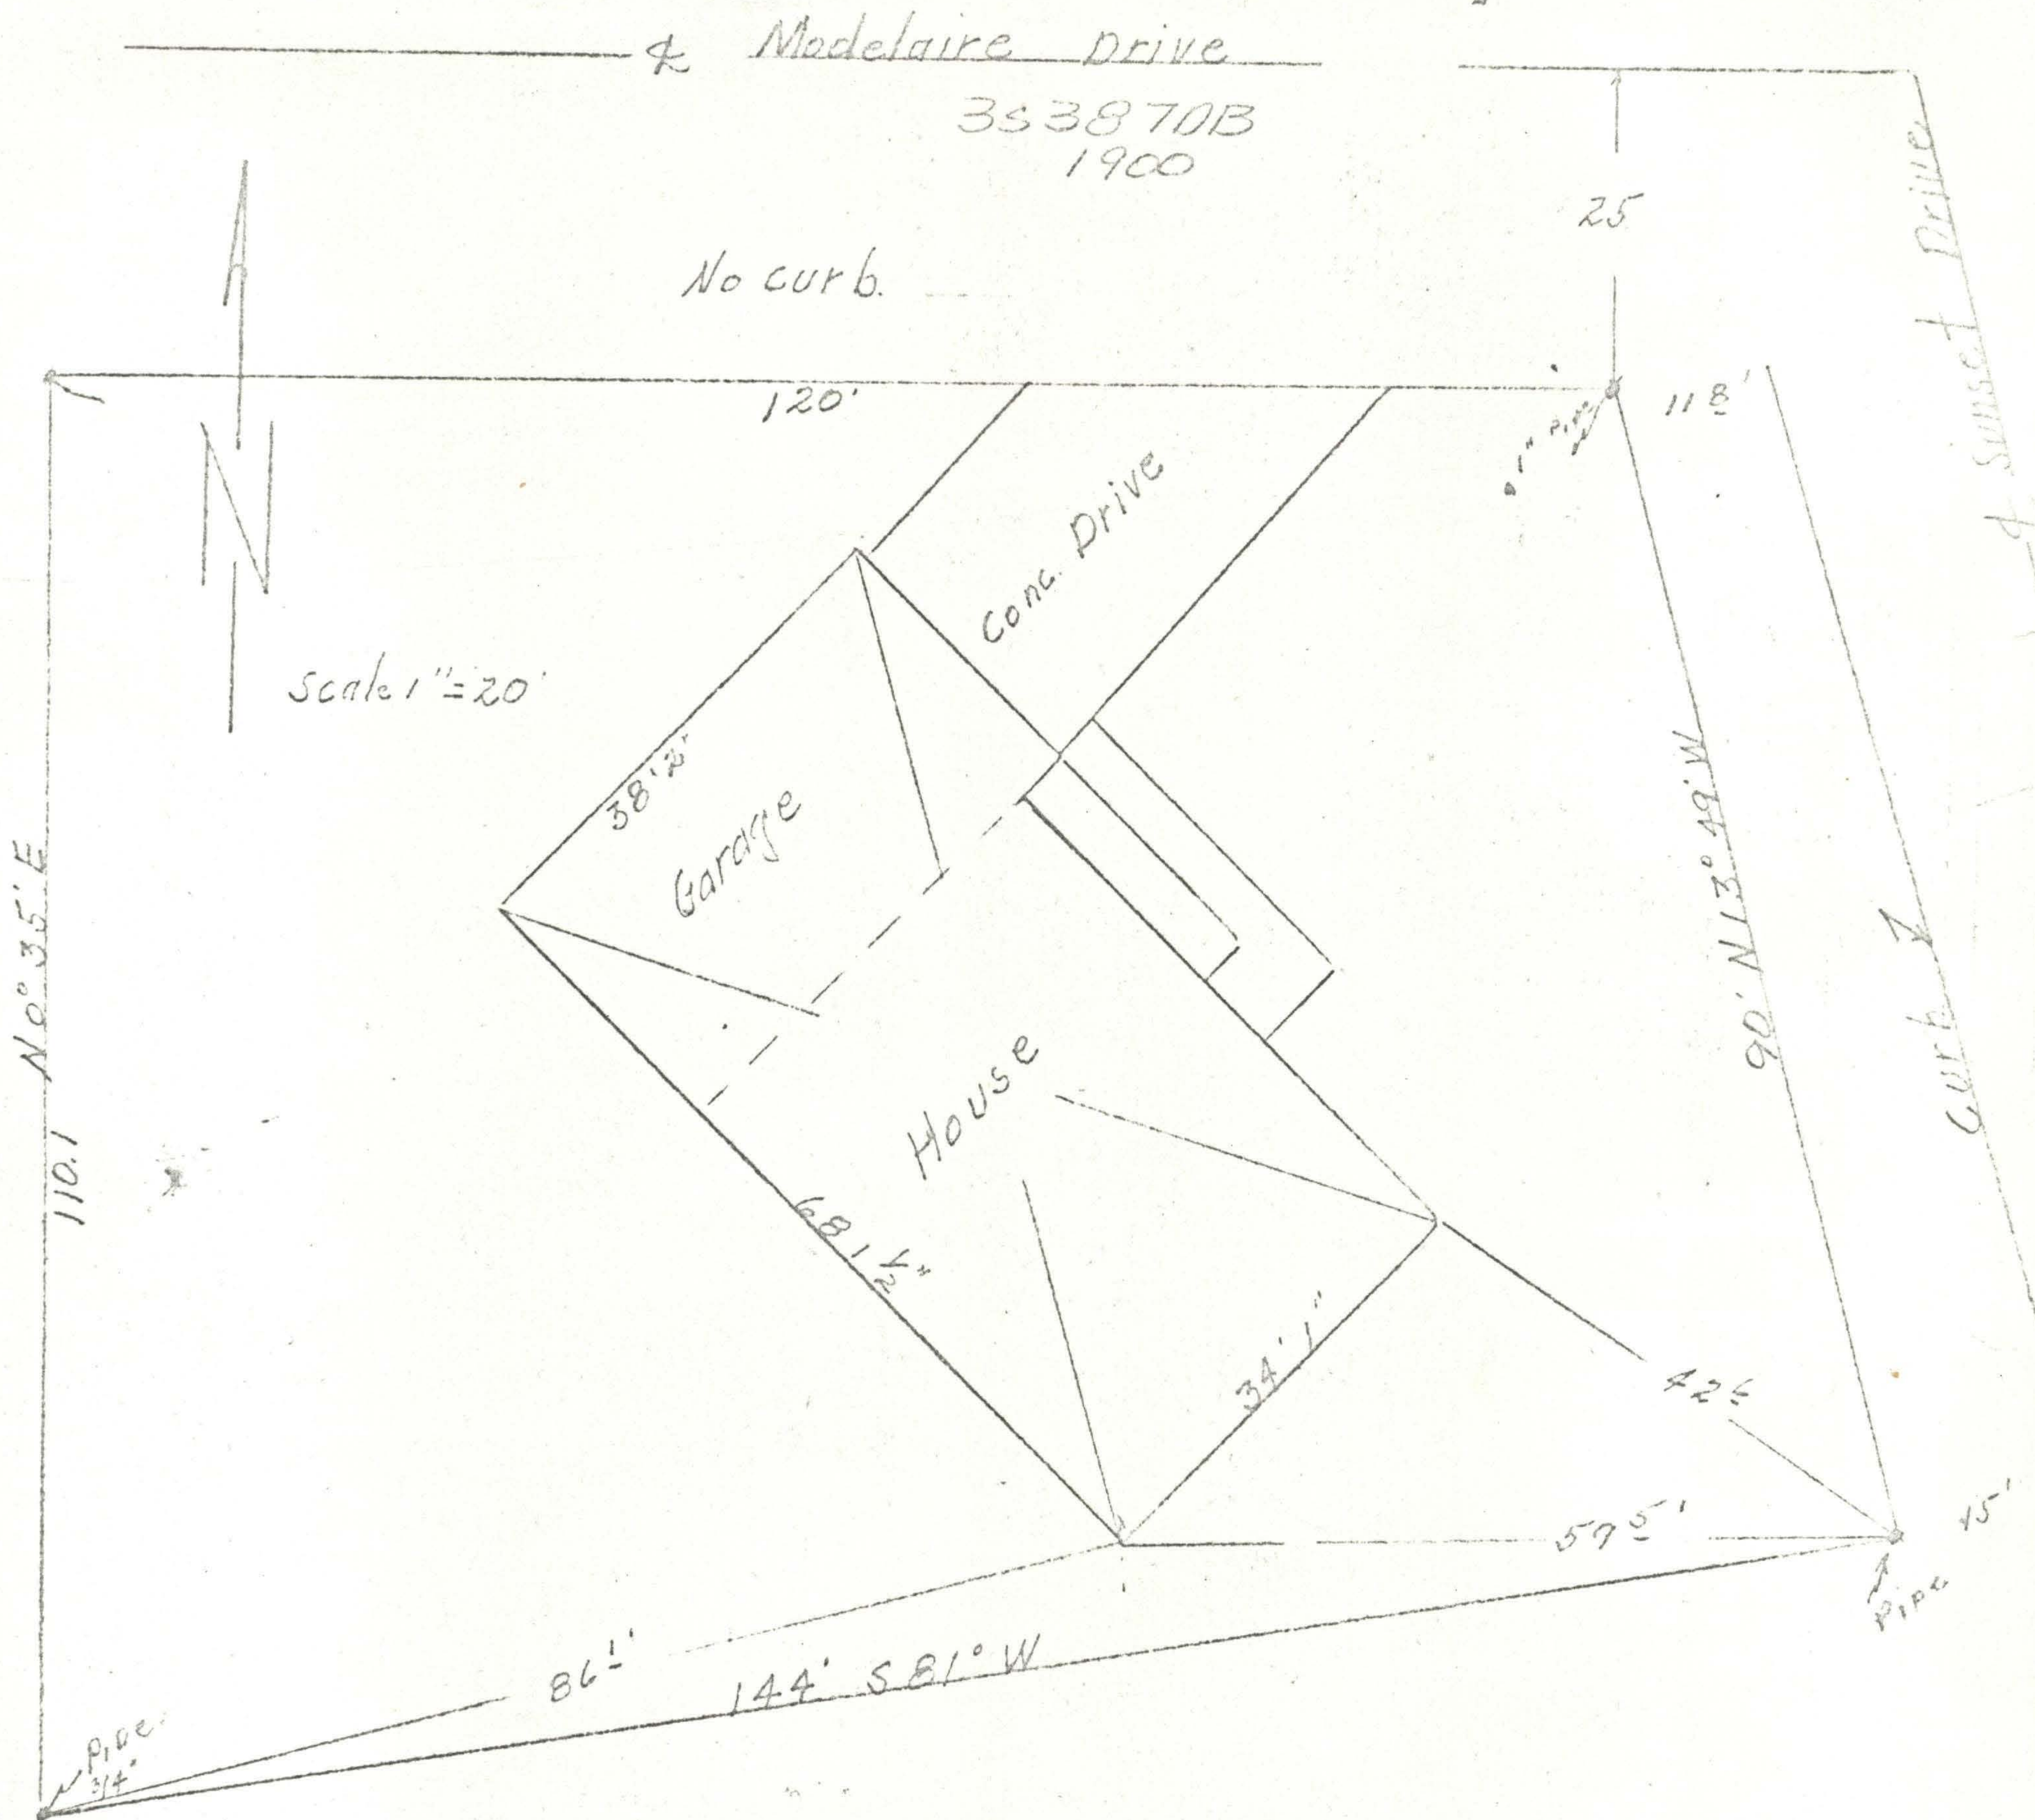

Description; Lot 31 of Modelaire Heights Addition to La Grande, Oregon

I certify there are no encroachments onto or off of described property as shown.

REGISTERED
OREGON
LAND SURVEYOR

James G. Voelz
MAY 4, 1950
JAMES G. VOELZ
381

43-65

43-65