


46-65

59-9b

NOTE:

MULTIPLY CALL DIST. BY 0.998867.
This checks Monuments & St const.

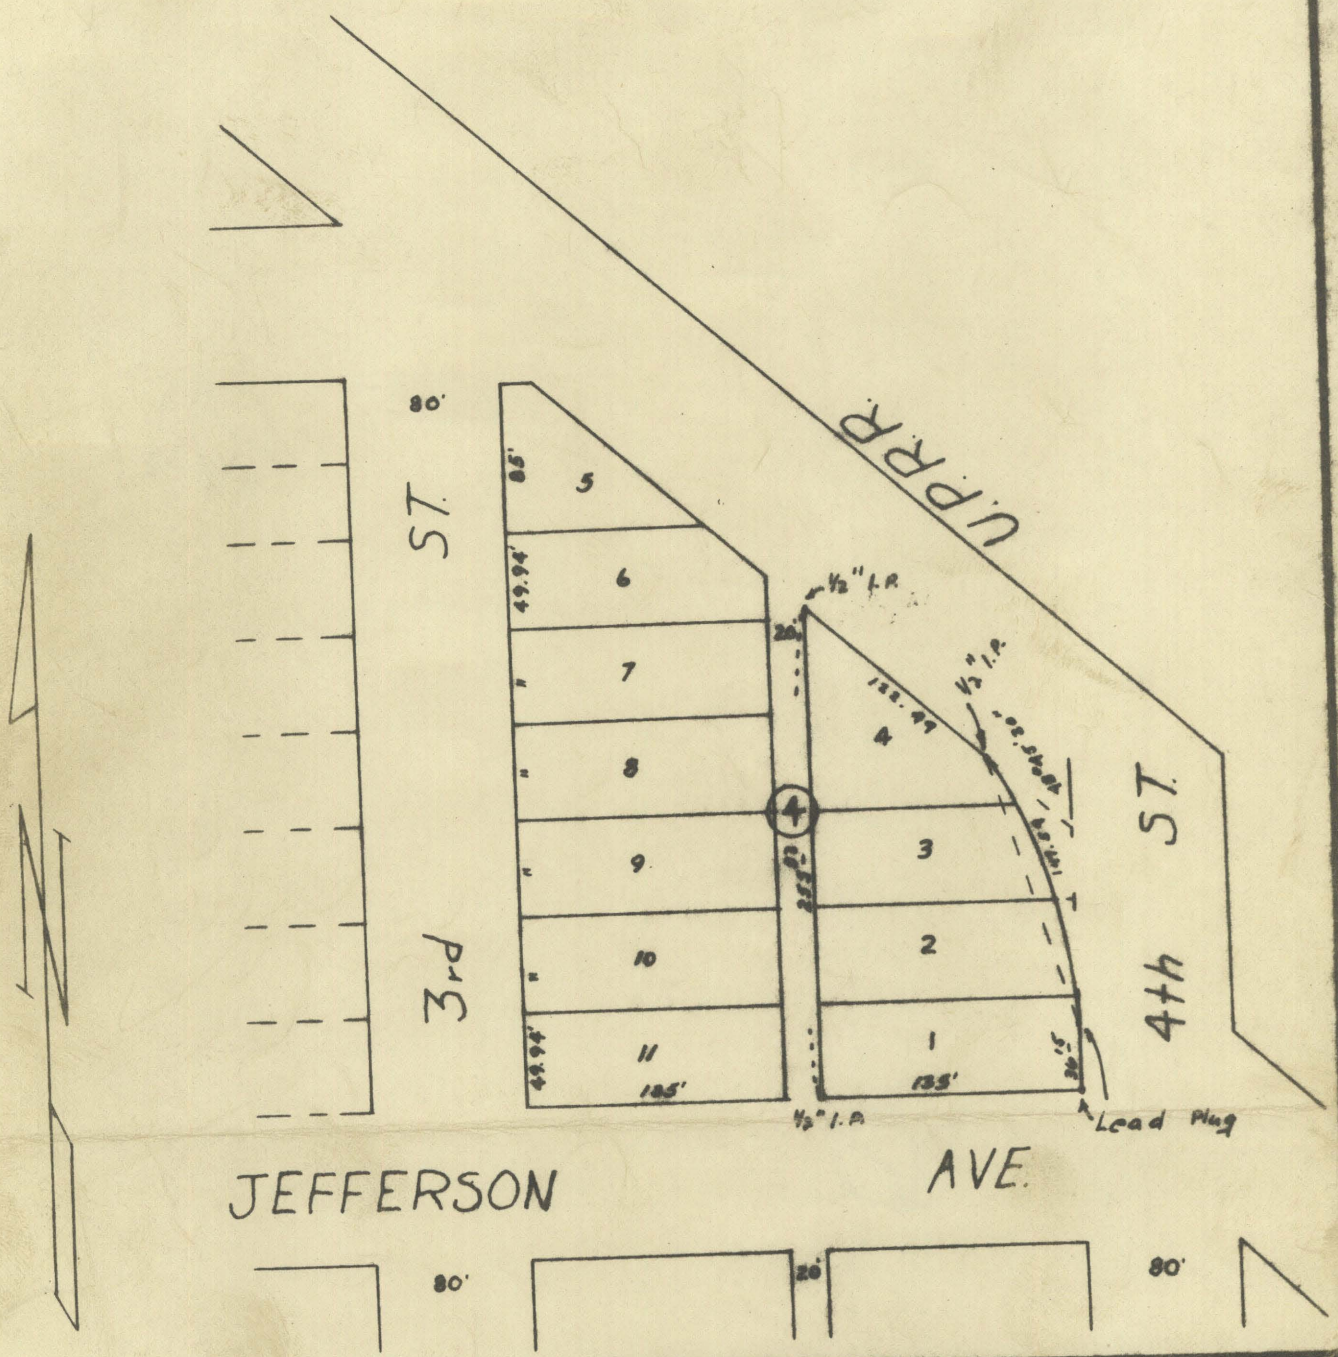

REGISTERED
OREGON
 LAND SURVEYOR

Wayne O. Harris

MAY 6, 1938
 WAYNE O. HARRIS
 346

HAYES AND HARRIS			
SURVEY FOR TEXACO, INC.			
LOTS 1, 2, 3, & 4 GRANDY'S LAGRANDE		BLOCK 4 ADDITION OREGON	
SCALE	DATE	DRN. BY	DRNG. NO.
1"=100'	4-5-65	ER	65- 211

46-1965