


7-66

Gus Tsiatsos  
407 3rd. Street  
La Grande, Oregon

Date April 22, 1966

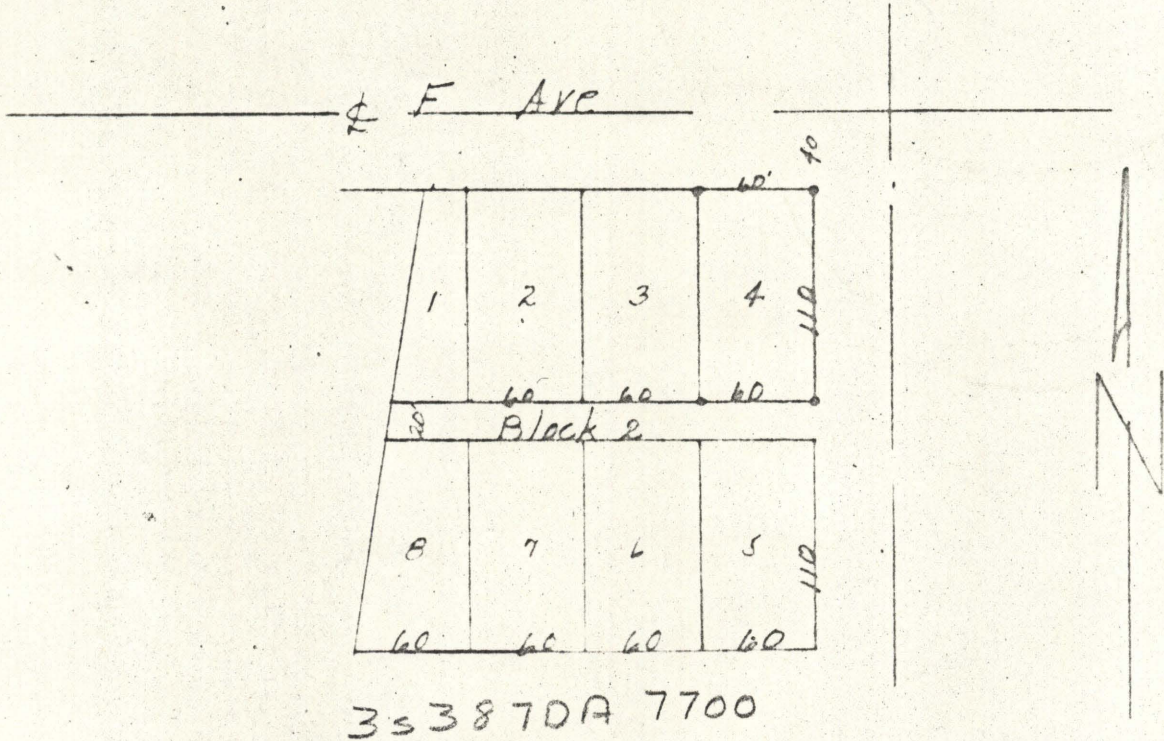

Scale 1" = 100'

Description; Lot 4 of Block 2 of Arnold & Dray Addition to  
La Grande, Oregon

REGISTERED  
OREGON  
LAND SURVEYOR

*James G. Voelz*  
MAY 4, 1956  
JAMES G. VOELZ  
381

7-66

766