

99-8


99-8

8-66

Survey for
Claire McManus
905 Spring
La Grande, Oregon

Date March 1, 1966

Description; Lot 6 of Block 8 of Deals Addition to La Grande, Oregon
ALSO the strip between Lot 6 of Block 8 of Deals Addition to
La Grande, Oregon Lot 2 of Block B of Wisdoms Addition to
La Grande, Oregon.

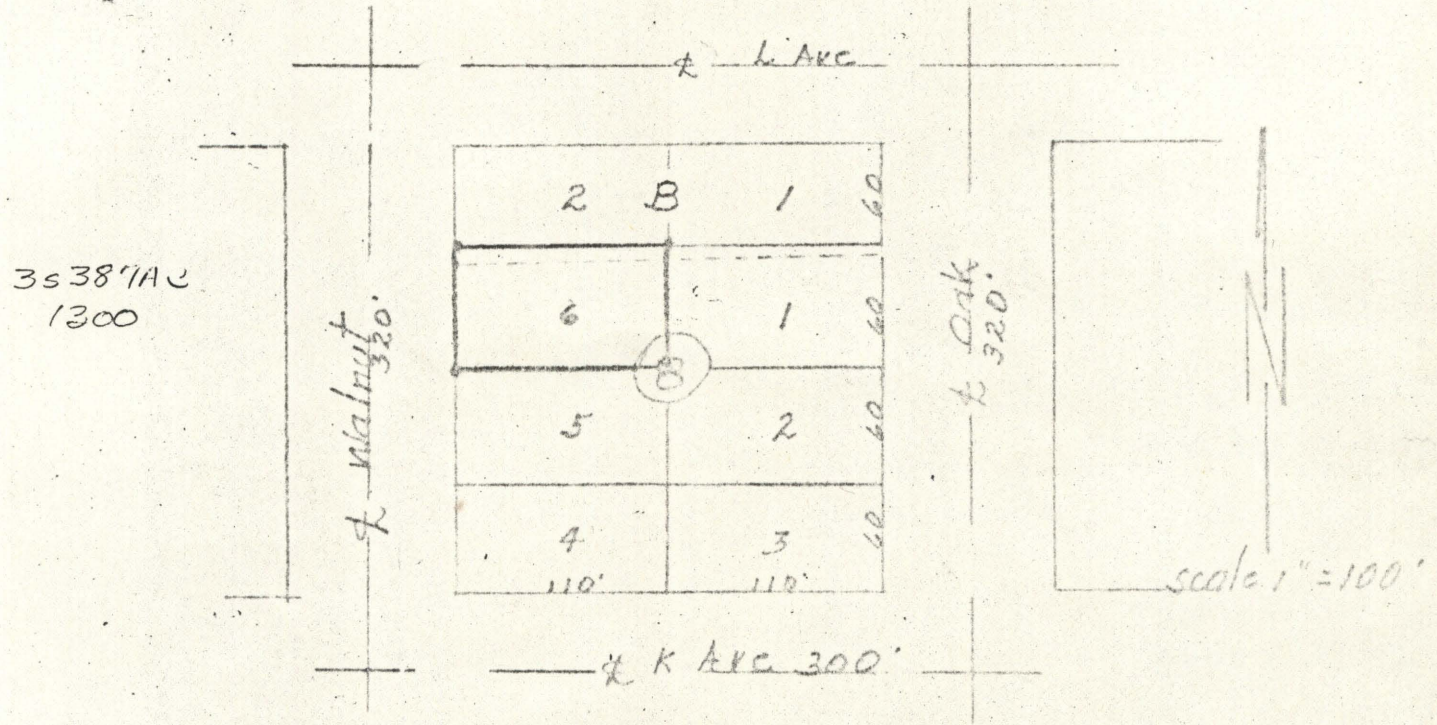

REGISTERED
OREGON
LAND SURVEYOR

James G. Voelz

MAY 4, 1956
JAMES G. VOELZ
381