

10-66


99-01

10-66

Robert D. & Flora E. Johnson
1508 X. Avenue
La Grande, Oregon

Date March 29, 1966

X AVE

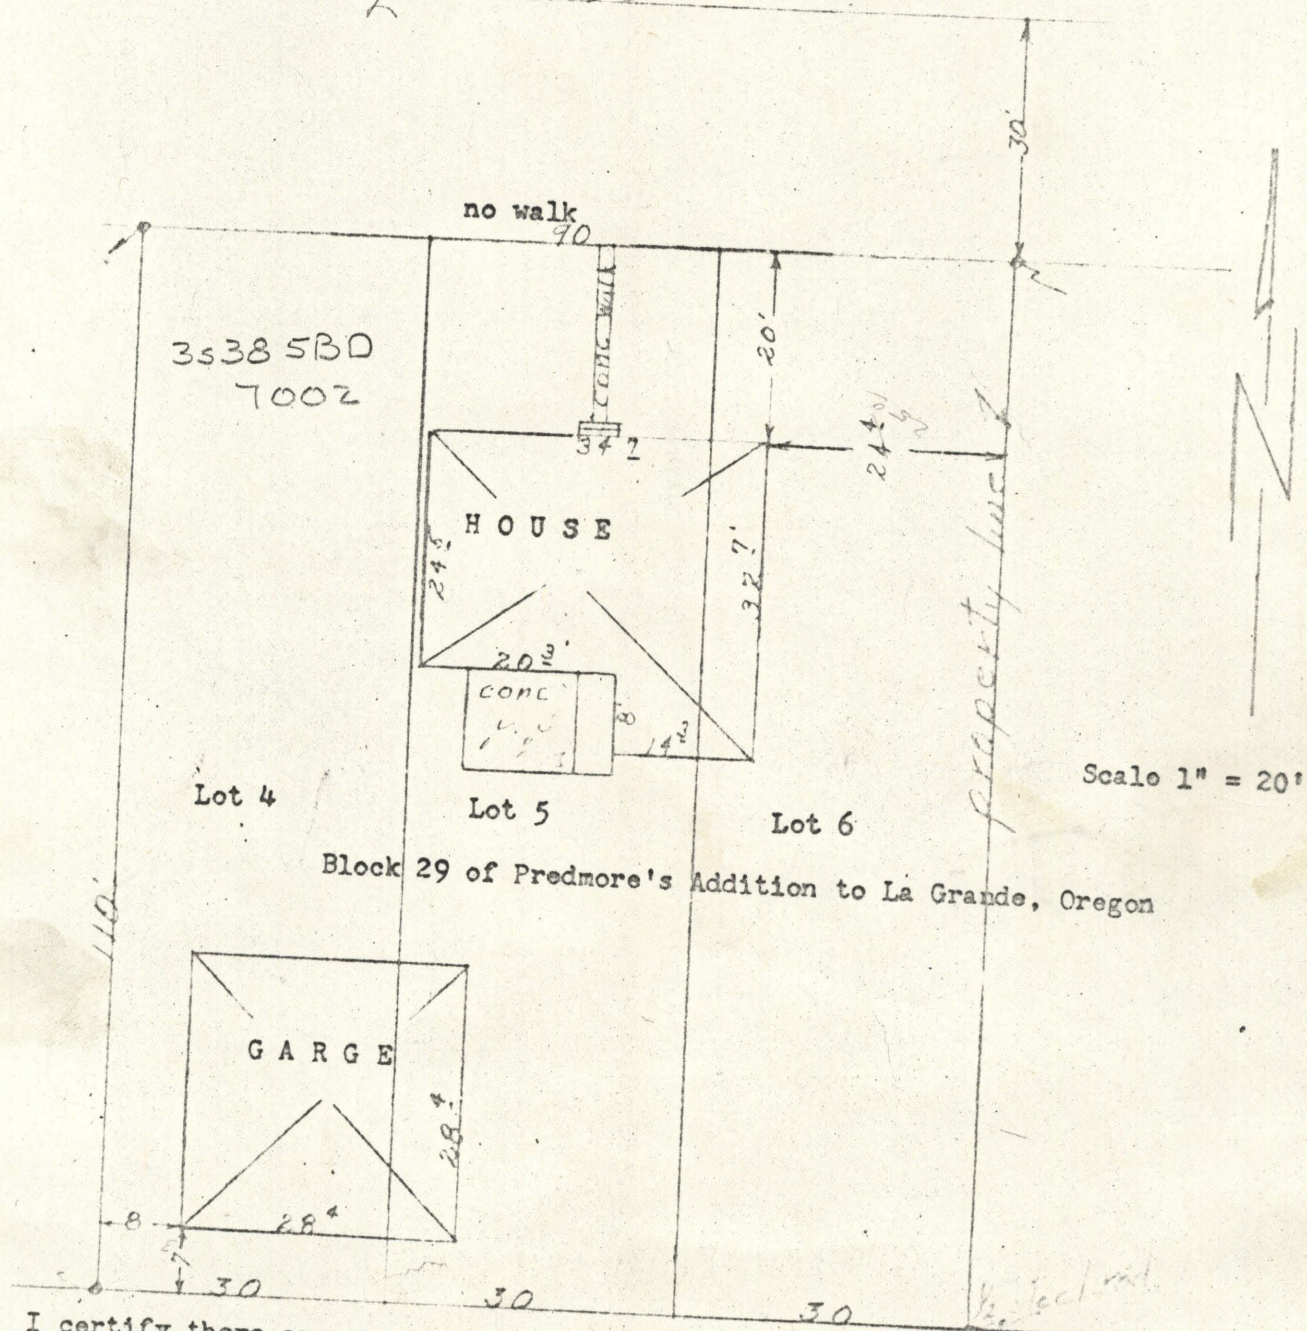

I certify there are no encroachments onto or off of described property.

REGISTERED
OREGON
LAND SURVEYOR

James G. Voelz
MAY 4, 1958
JAMES G. VOELZ
381