

Date survey, Jan, Feb. and March 1966


**UNION COUNTY
SURVEYOR**

Date Received 3-4-87

Date Filed _____

By G. LANGLITZ, DEPUTY

File No. 11-66

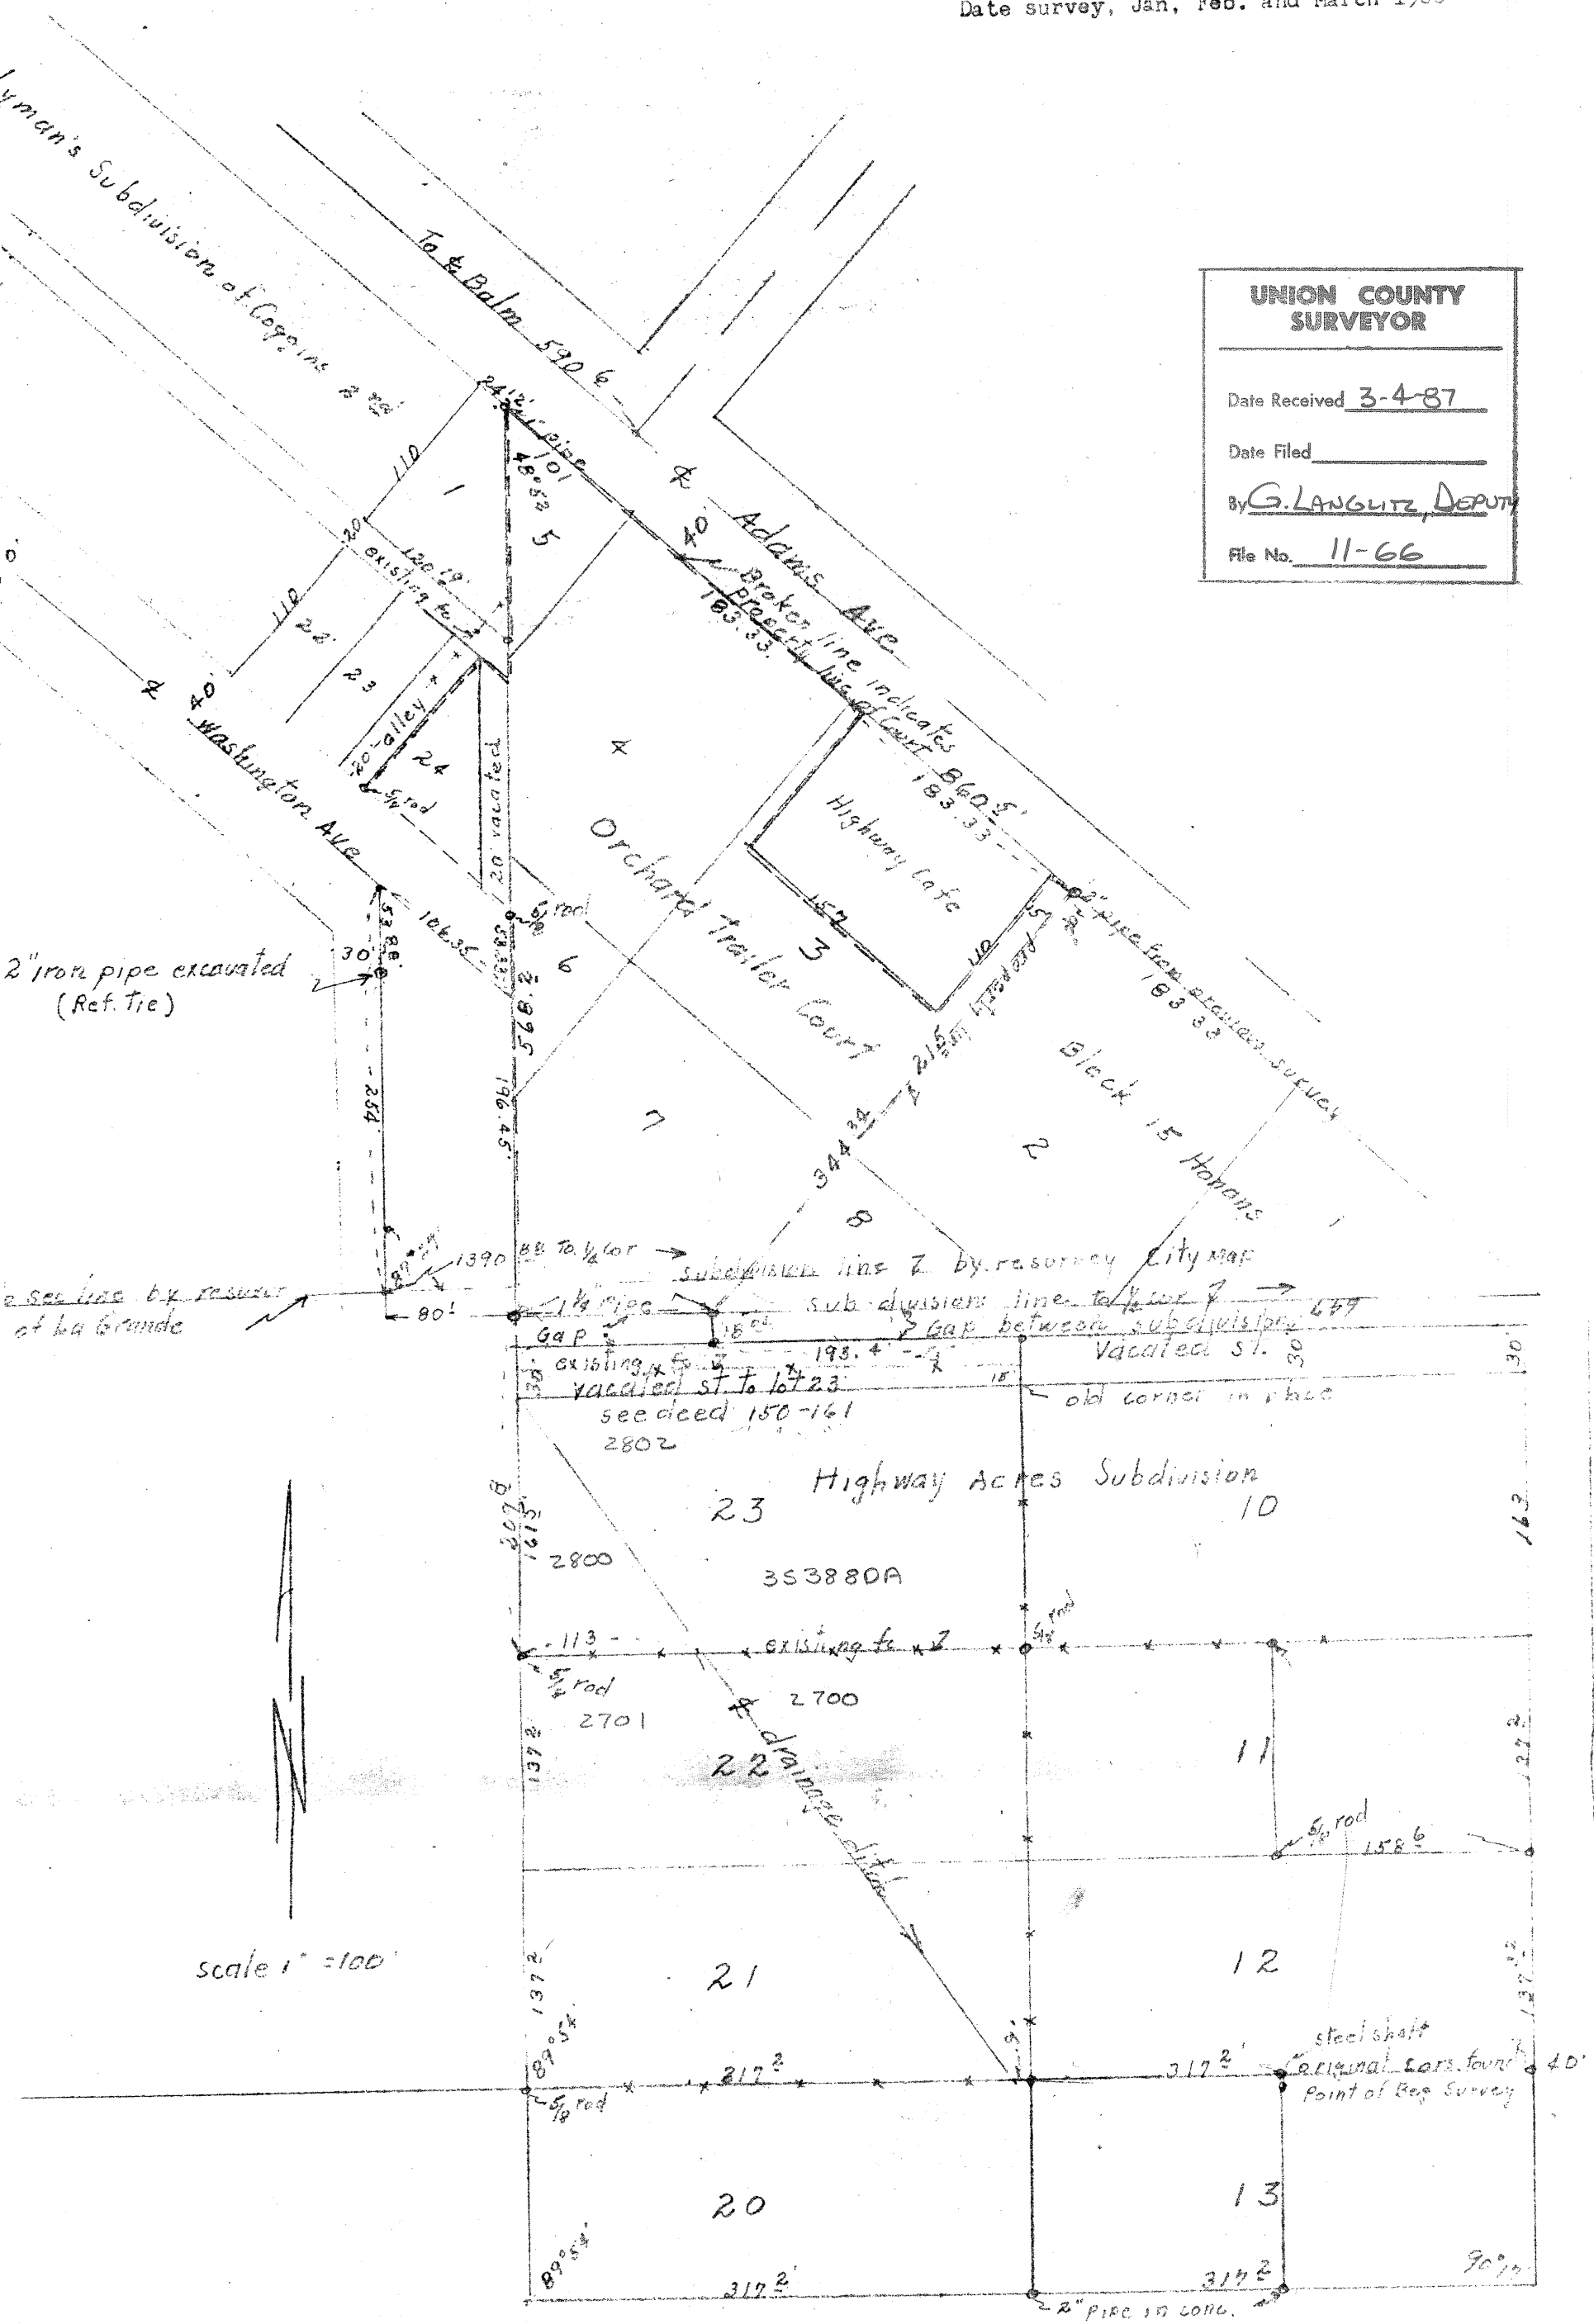

scale 1" = 100'

James Black

11-66