


Forrest D. & Merle G. Sherman  
1606 Washington Ave.  
La Grande, Oregon

April 27, 1966

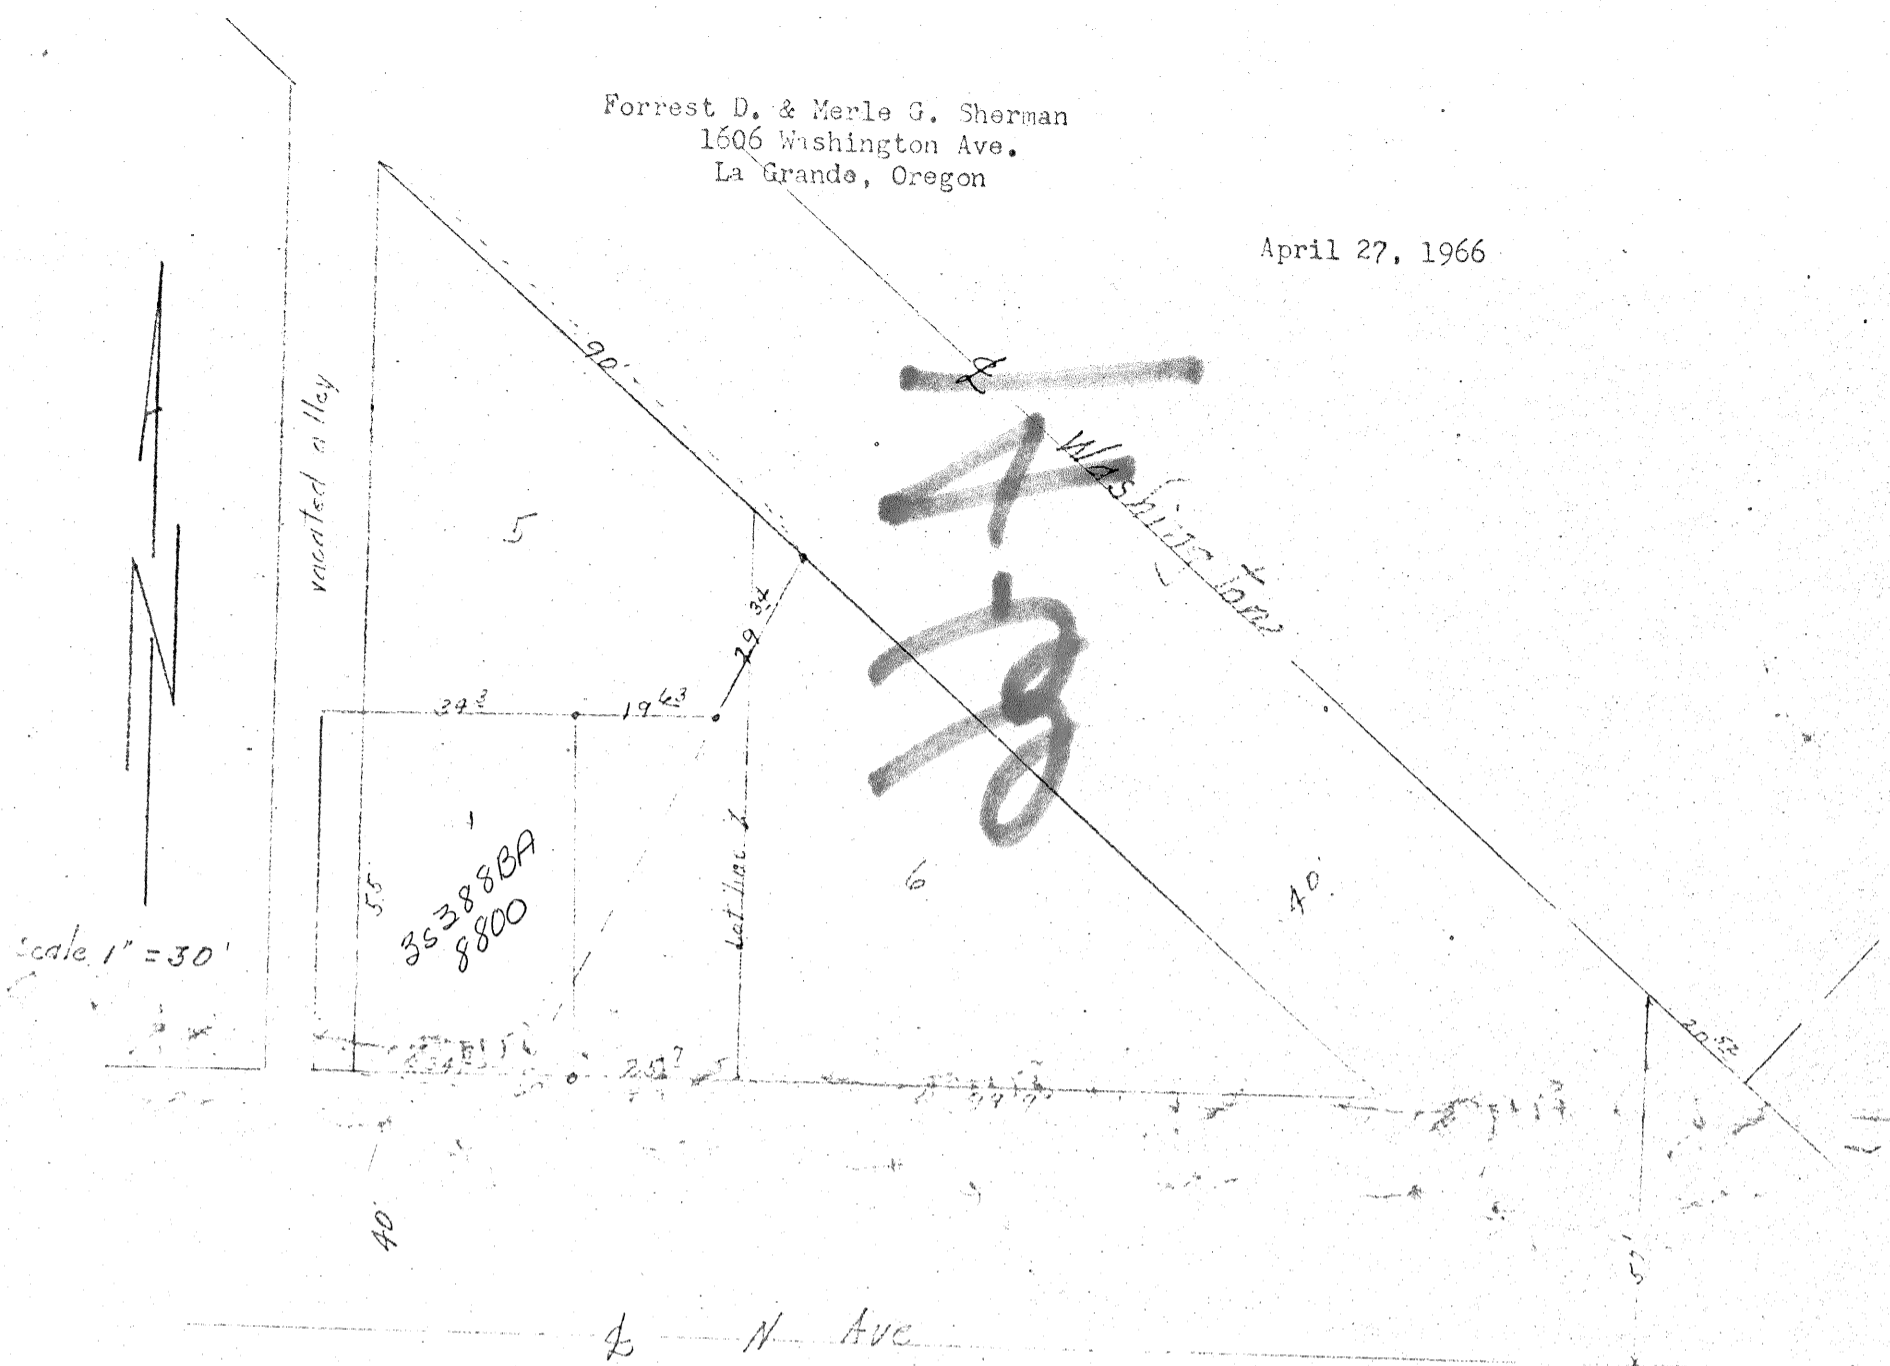

Existing description as of survey date;  
The south fifty-five feet of the following described tract of land, to wit;  
Commencing at the northwest corner of lot five of McIntosh's Subdivision of Block 11 of Coggin's Addition to La Grande, Union County, Oregon, and running thence south to the southwest corner of Lot 5 of said Block; thence east on the south line of said lot a distance of 25 feet; thence northeasterly to a point on the northeasterly line of lot 6 of said block, which point is 90 feet so theasterly from the point of beginning; thence northwesterly to the point of beginning. Also that part of the alley adjacent to the south 55 feet of said tract, to the center of said alley, which has accrued by reason of vacation of said alley by City Ordinance No. 1382 Series 1940. Situated in the city of La Grande, Union County, Oregon.

NEW DESCRIPTION:

The south fifty five feet (55) of the west 34.3 of Lot 5 of McIntosh' Subdivision of Block 11 of Coggin's Addition to La Grande, Oregon.  
Also that part of the alley adjacent to the south 55 feet of said tract to the center of said alley, which accrued by reason of vacation of said alley by City Ordinance No. 1382 Series 1940. Situated in the city of La Grande, Union County, Oregon.

*Forrest D. Sherman*

14-66