



17-66

Bert Rysdam
Elgin, Oregon

June 2 to 14, 1966

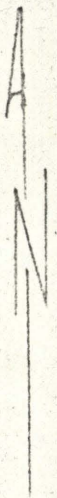

T3N, R40EWM.
Cor. marker found in place

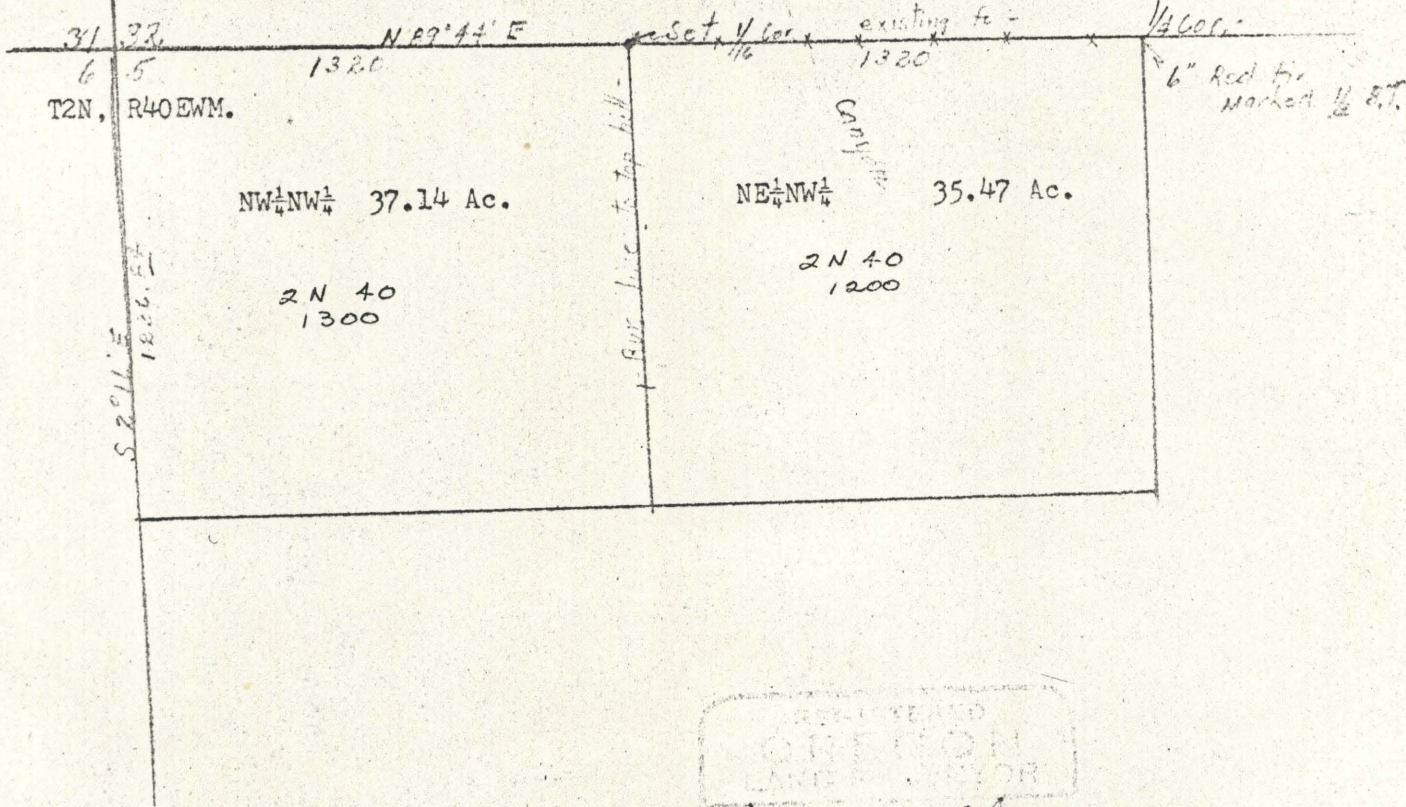

RECEIVED
OREGON
LAND DIVISION
JAMES G. VOHIZ
MAY 11 1966
331

17-66

17-66