19-66

Charles A. Bieker ~~III~~
1312"O" Avenue
La Grande, Oregon

June 30, 1966

Scale 1"= 20'

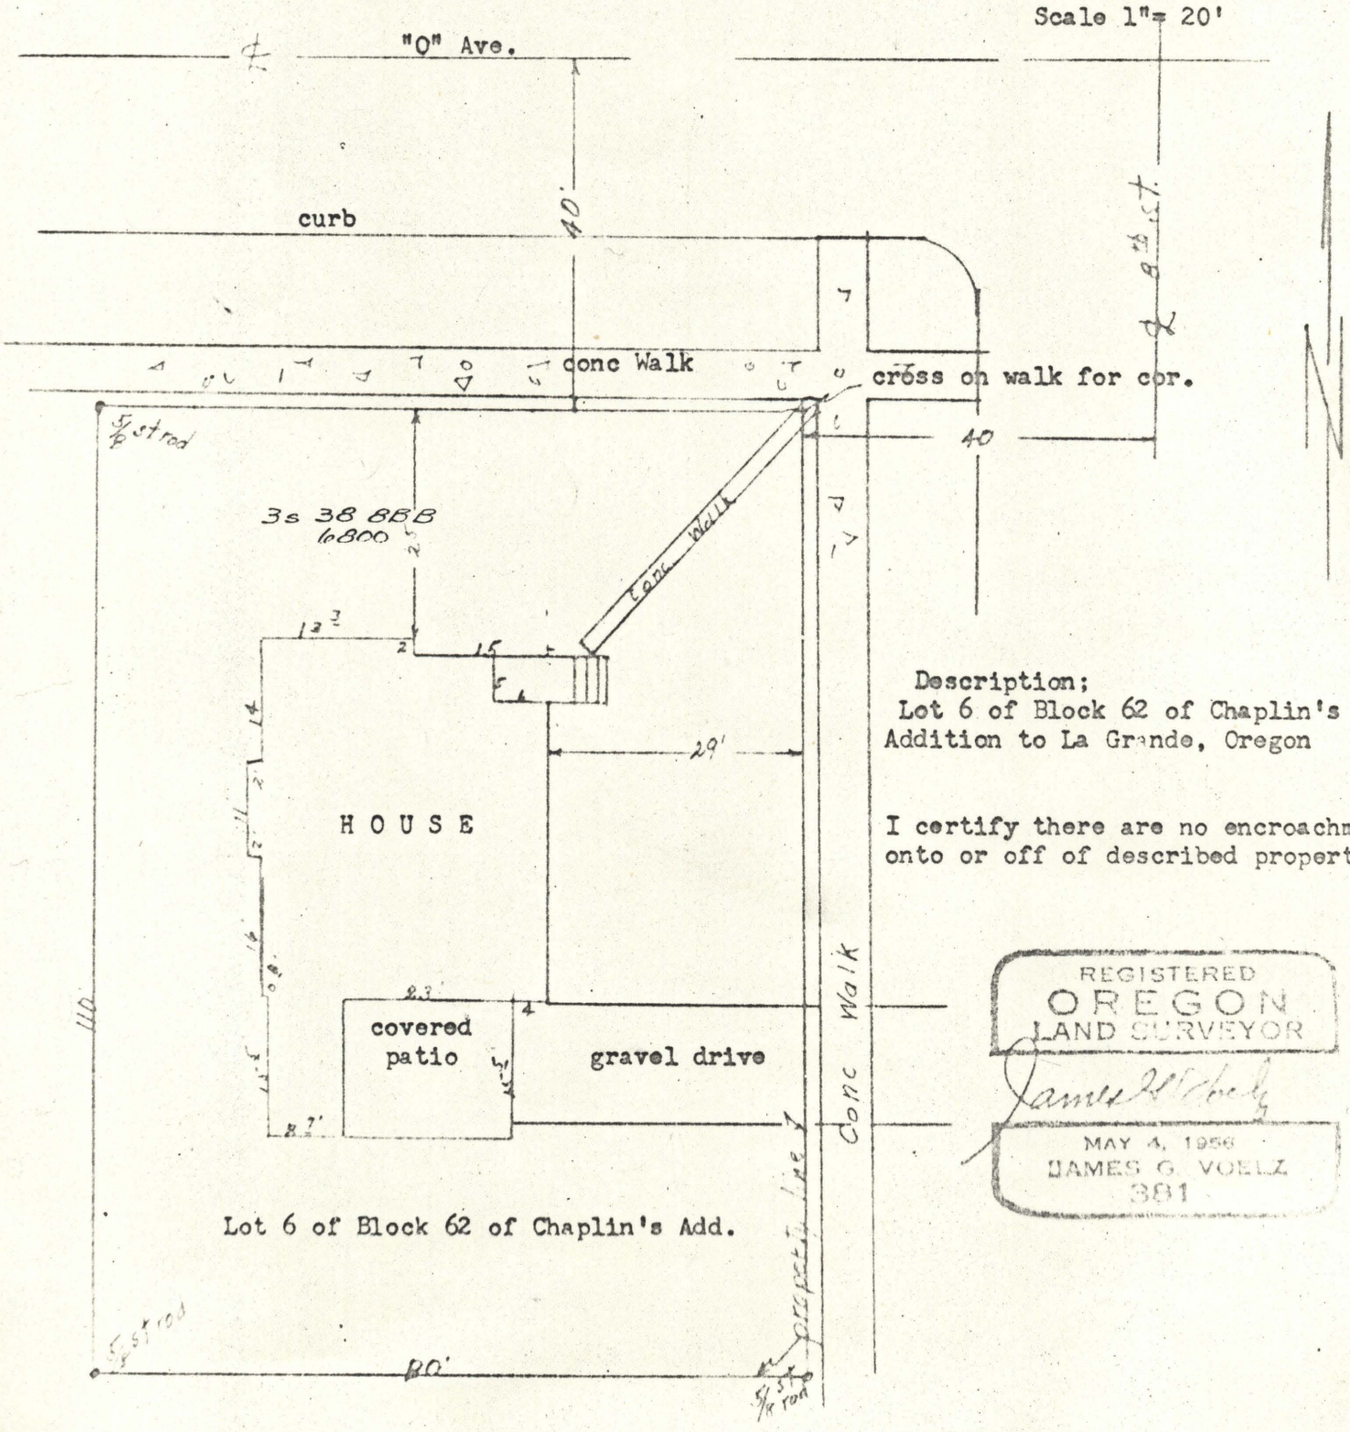

Description;
Lot 6 of Block 62 of Chaplin's Addition to La Grande, Oregon

I certify there are no encroachments onto or off of described property.

REGISTERED
OREGON
LAND SURVEYOR
James G. Voelz
MAY 4, 1956
JAMES G. VOELZ
381

19-66

19-66