

24-66



99-62

24-66

Glenn Muilenburg
Rt. 2
La Grande, Oregon

Date September 20, 1966

T-3-S, R39EWM.

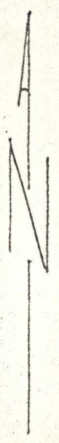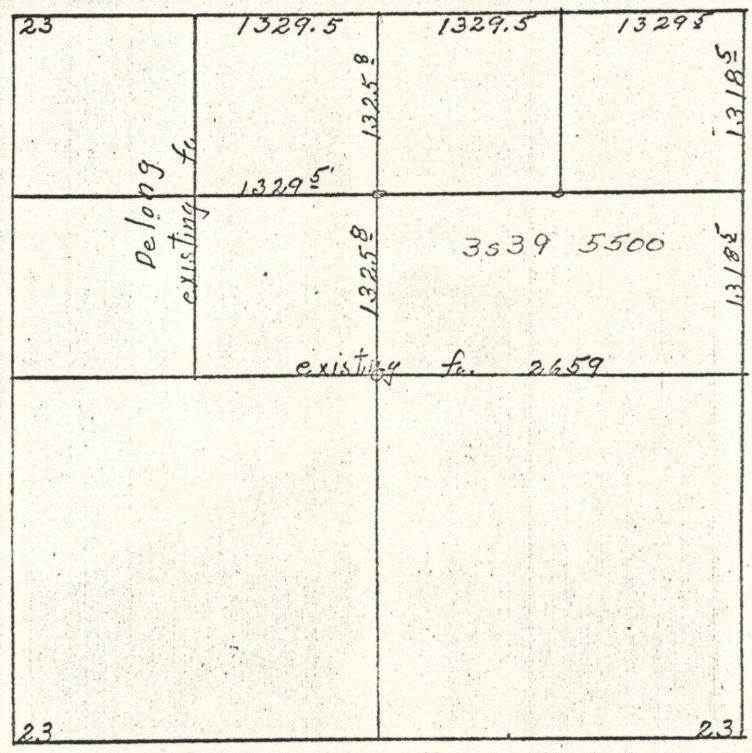

scale 1" = 1320'

Survey of NE $\frac{1}{4}$ section 23, T3S, R39EWM.

REGISTERED
OREGON
LAND SURVEYOR

James G. Voelz

MAY 4, 1956
JAMES G. VOELZ
391