
John Carlson Box 726 Baker, Oregon

XEBO

XERO

September 13, 1966

XILBOT

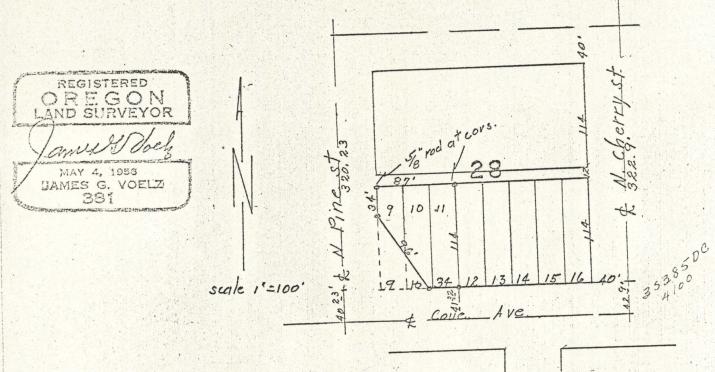

Description; WILLIAMSON'S ADDITION
Beginning at the NE corner of lot9 of Block 28;
Thence south along the east line of said lot 9 a distance of 77.75 ft.;
Thence in a northwesterly direction a distance of 52.3 ft. to a point on the west line of and 34 ft. south of the NW corner of said lot 9;
Thence north 34 ft. to NW corner of said lot 9;
Thence east along the N orth line of said lot9 a distance of 29 ft. to point of beginning.

ALSO; Beginnig at the southeast corner of lot 10 Block 28; Beginnig at the south line of said lot 10 a distance of 5 ft.; Thence west along the south line of said lot 10 a distance of 43.7 ft. to a point Thence in a northwesterly direction a distance of 43.7 ft. to a point on the west line of and 77.75 ft. south of the NW corner of said lot 10.; Thence north 77.75 ft. along the west line of said lot 10 to the NW corner of said lot 10; Thence east along the north line of said lot 10 a distance of 29 ft. to the NE corner of said lot 10.; Thence south along the east line of said lot 10 a distance of 114 ft. to the point of beginning. ALSO: all of lot 11 of block 28.

26-66

16-66