


27-66

J. T. Hagerty  
1610 Oak  
La Grande, Oregon

Date, Sept. 8, 1966

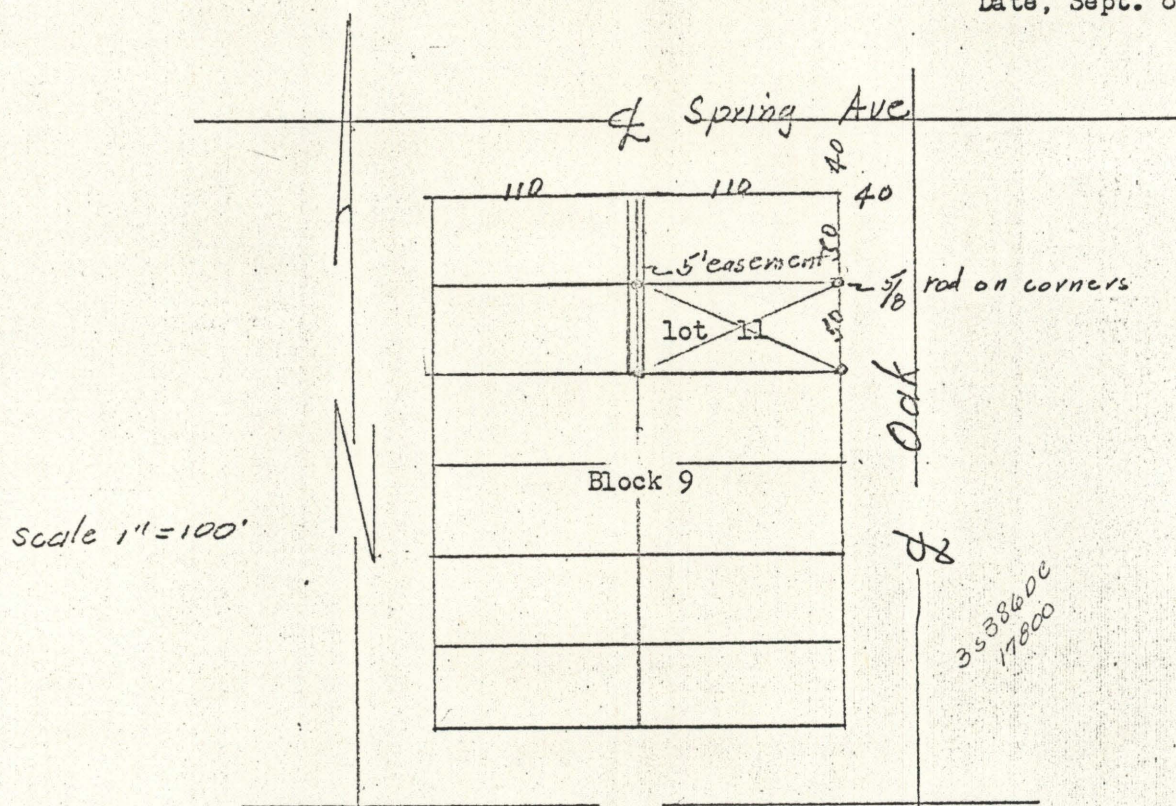

Description,  
Lot 11 in Block 9 of Romig's Addition to La Grande, Oregon

REGISTERED  
OREGON  
LAND SURVEYOR

*James G. Voelz*

MAY 4, 1958  
JAMES G. VOELZ  
381

27-66

27-66