


Survey for
Merrell Decker -
405 4th.St.
La Grande, Oregon

Date Jan. 10, 1966

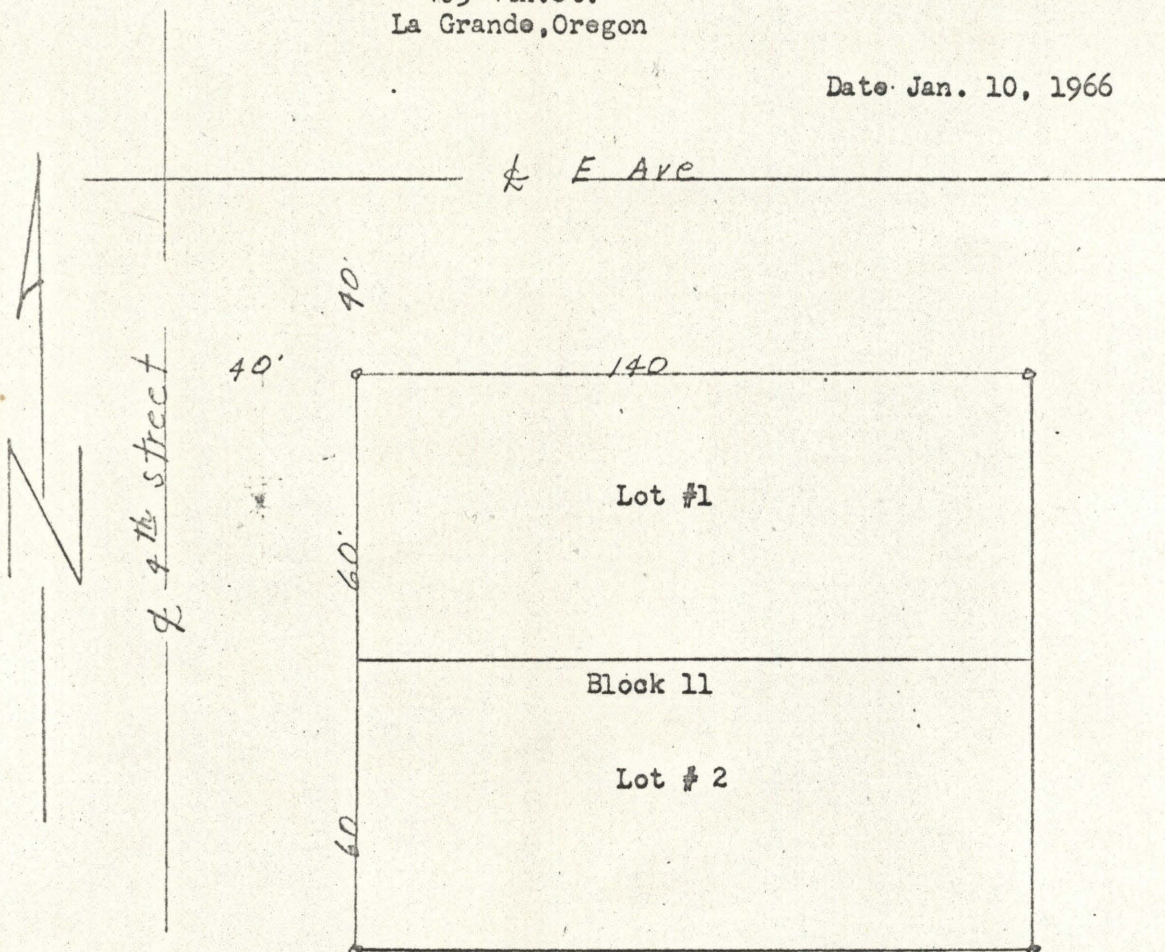

Description; Lots 1 and 2 of Block 11 of Chaplin's Addition
to La Grande, Oregon.

REGISTERED
OREGON
LAND SURVEYOR
James G. Venz
MAY 4 1966
JAMES G. VENZ
381

30-1966

30-66

30-66