


Alex Shaw
501 A St.
La Grande, Oregon

May 18, 1966

Description;
Lot 3 and south 39 feet of lot 10 of Block 14 of Arnold's Addition to
La Grande, Oregon.

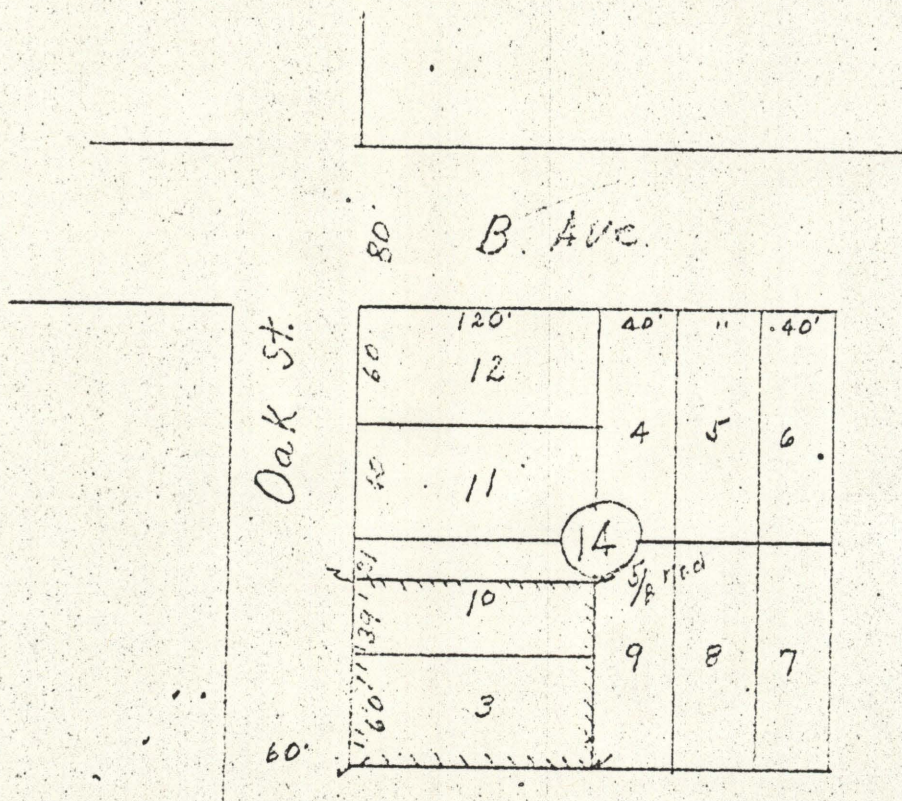

REGISTERED
OREGON
LAND SURVEYOR
James G. Voelz
MAY 4, 1959
DAMES & MOELLER
391

32-1966

32-66

32-66