



Harlan J. Kraus
2111 Cedar St.
La Grande, Oregon

June 11, 1966

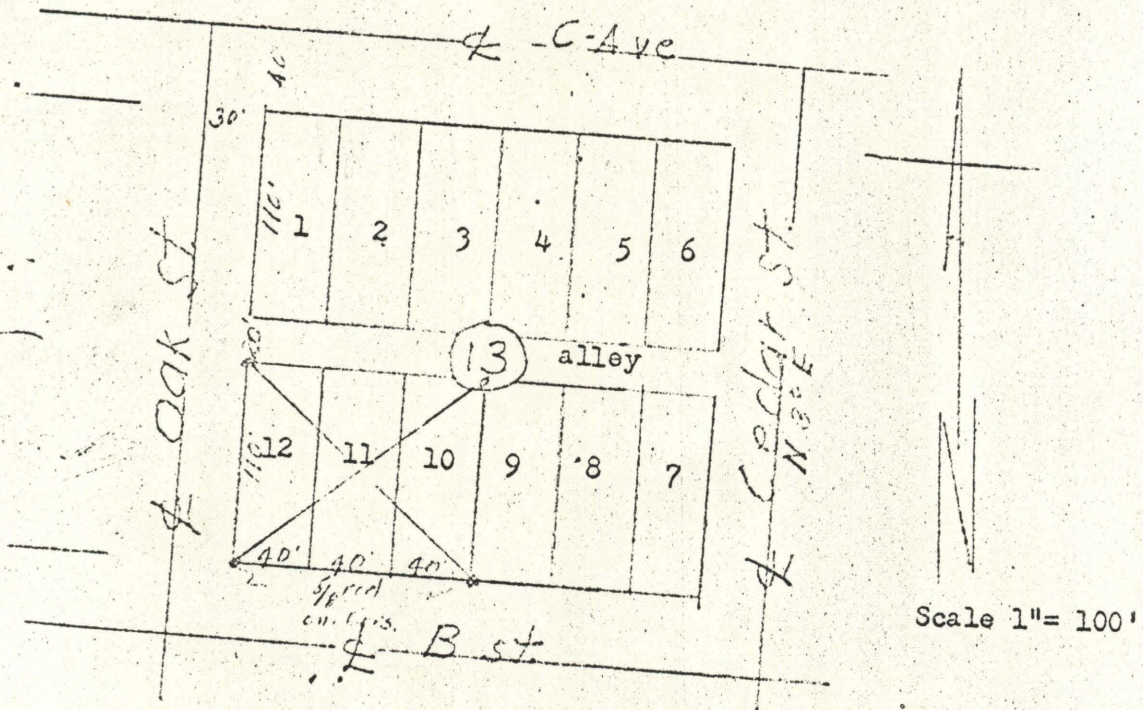

Description;
Lots 10, 11 & 12 of Block 13 of Arnold's Addition to La Grande, Oregon.

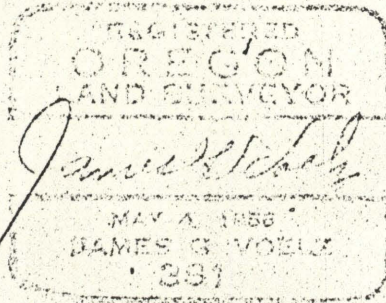

33-1966

33-66

33-66