
## 5.67

& O House

Marjoria A Nicoson Cove , Oregon

Date July 15, 1967

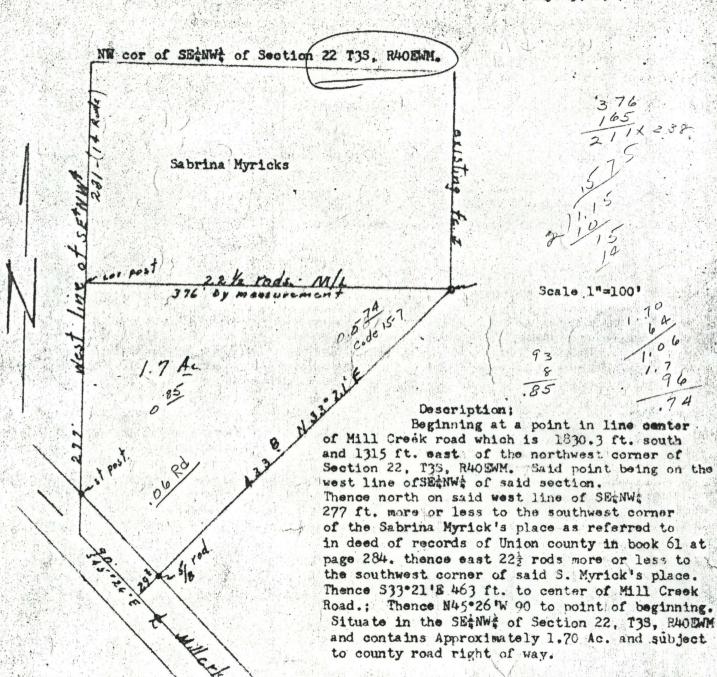

REGISTERED OR E GON LAND ETRVEYOR LAND ETRVEYOR MAY 4, 1959 JAMES G. VOELZ 381