

7-67

L9-L


35383

Robert Carey
1506 Cedar
La Grande, Oregon

619718⁹³
628715⁵¹ May, 1967

deeds refer to
corner as being on
west side of road.

concrete mon. was found on cor.
this monument is referenced
to U.P.R.R., R/W map
as located on ground.

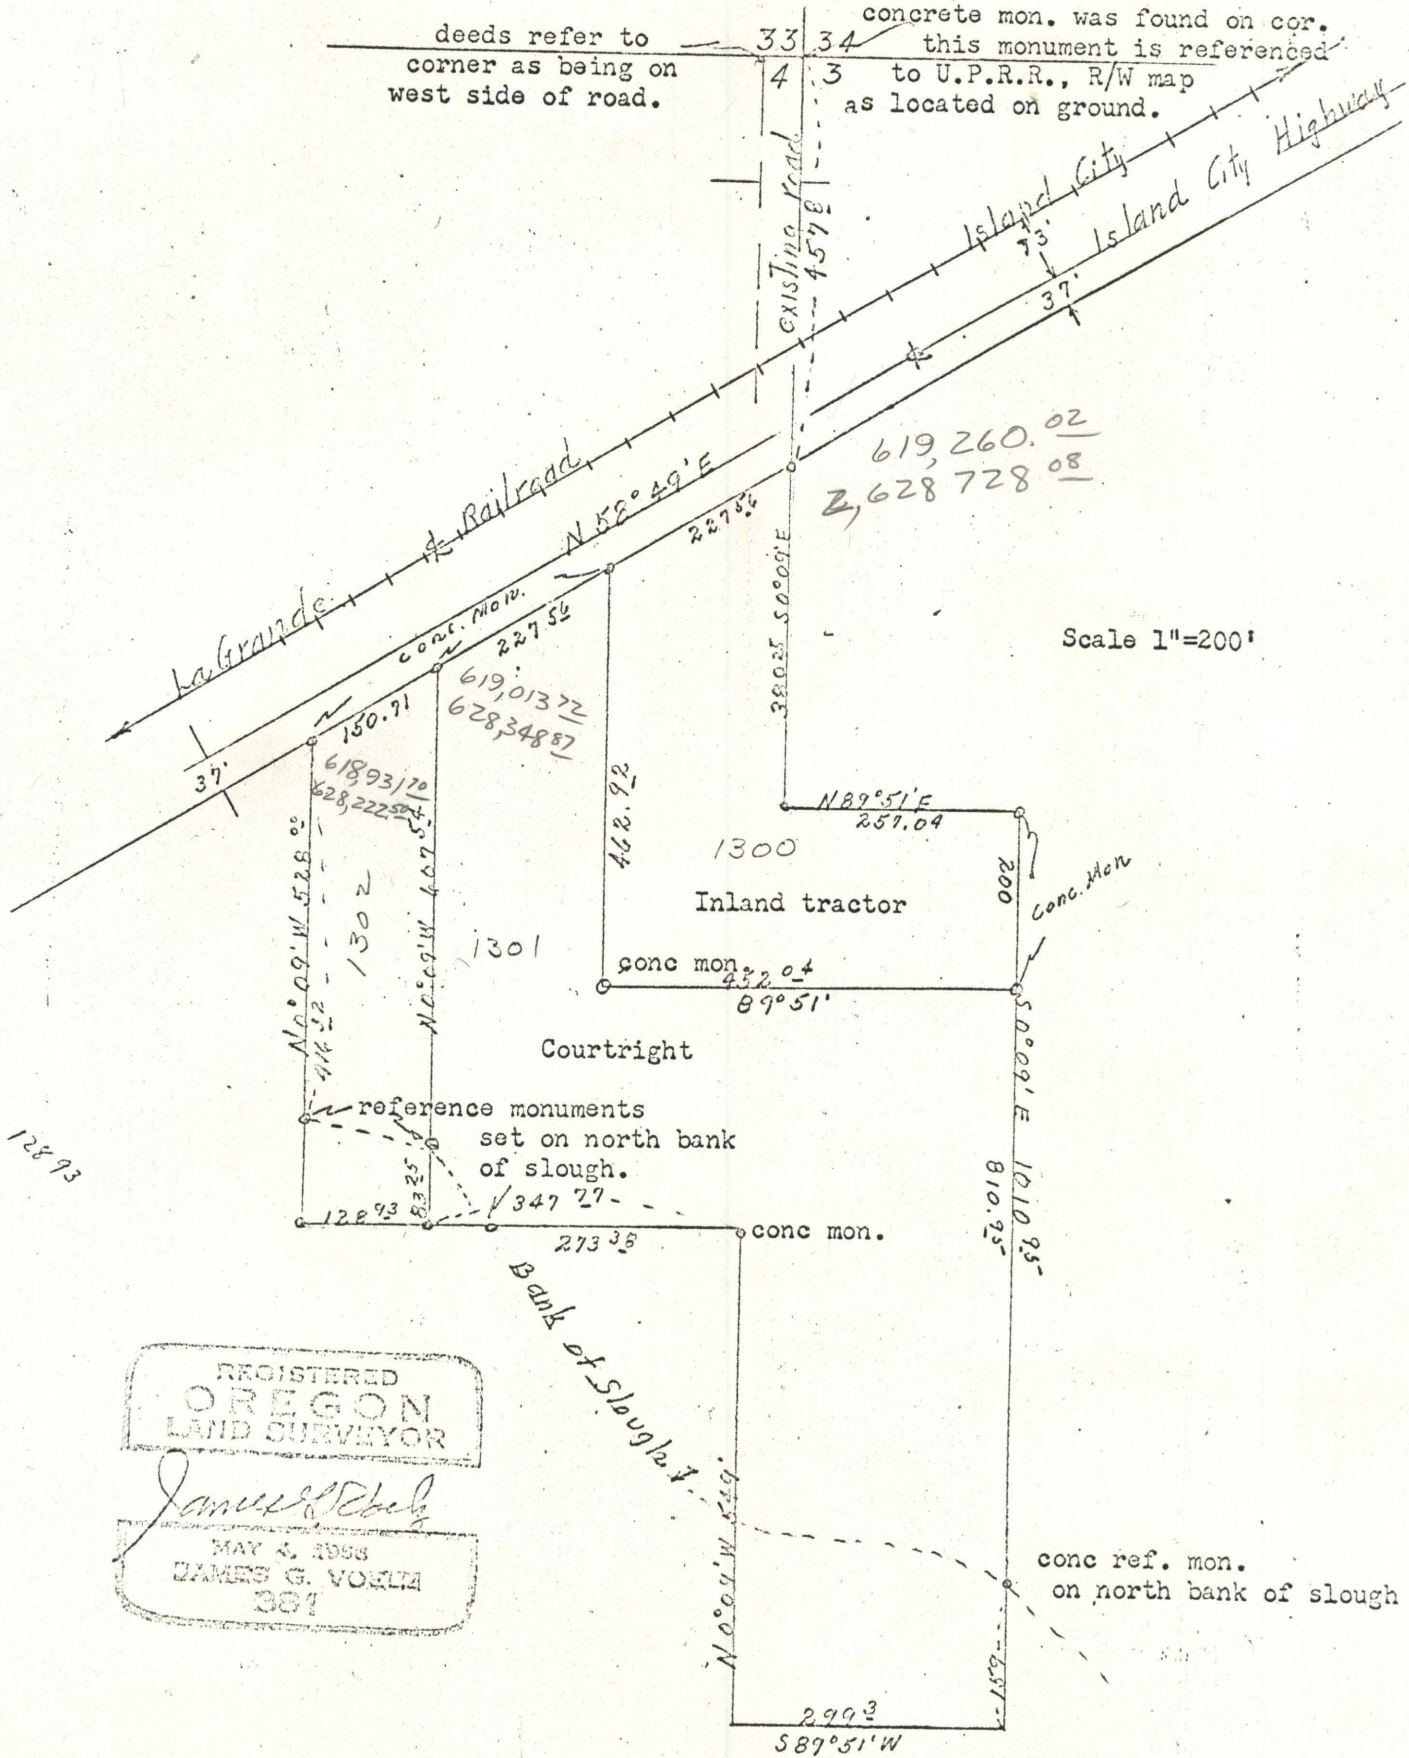

Scale 1"=200'

REGISTERED
OREGON
LAND SURVEYOR

James G. Vorliz
MAY 4, 1963
JAMES G. VORLIZ
381

128.93

11
11