


8-67

L9-8

Boise Cascade Corp.
Jackson & Willow
La Grande, Oregon

35385 AD
200

May 16 and 17, 1967

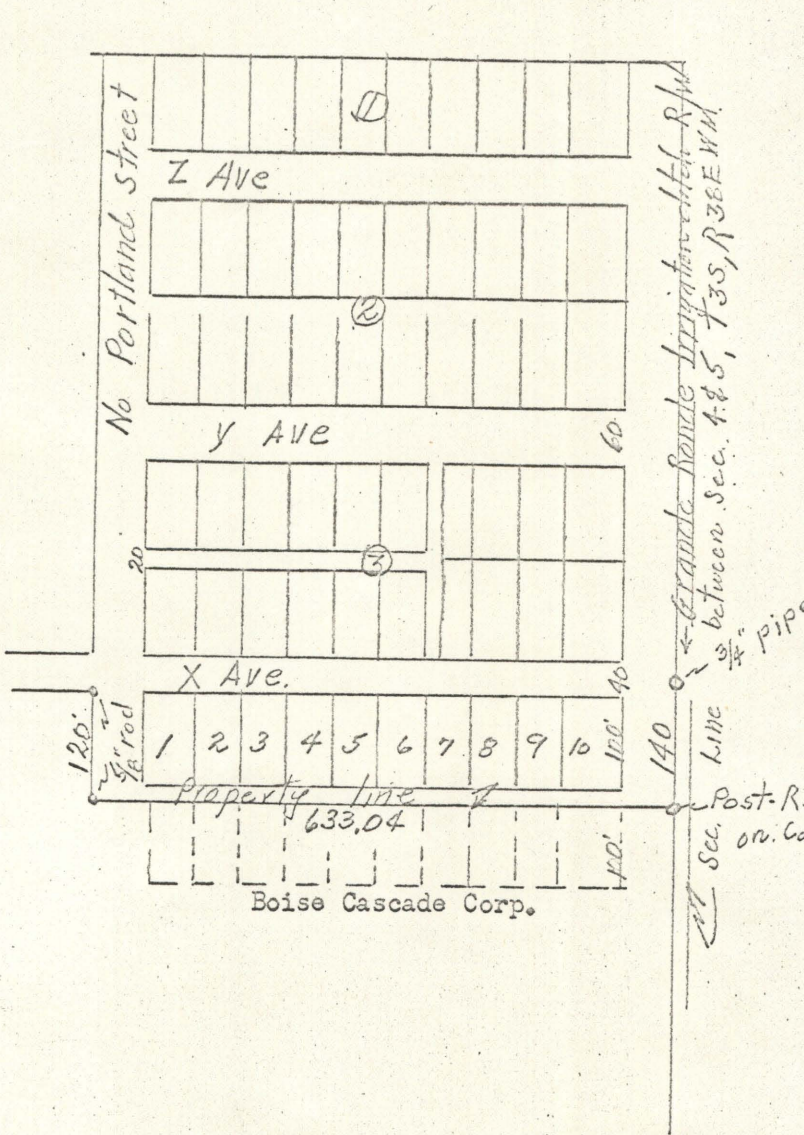

Establish south boundary of alley in Block 4 of Pratt's Subdivision to La Grande, Oregon, and the west side of North Portland Street adjacent to Block 4.

REGISTERED
OREGON
LAND SURVEYOR

James G. Voelz

MAY 4, 1930
JAMES G. VOELZ
381