

10-67


10-67

C.F.

Mrs. H.D. Wilson
1823 Z Ave.
La Grande, Oregon

June 28, 1967

Description;
The west 110 ft. of lots 3 and 4 of Block "C" of New Haven Addition
to La Grande, Oregon.

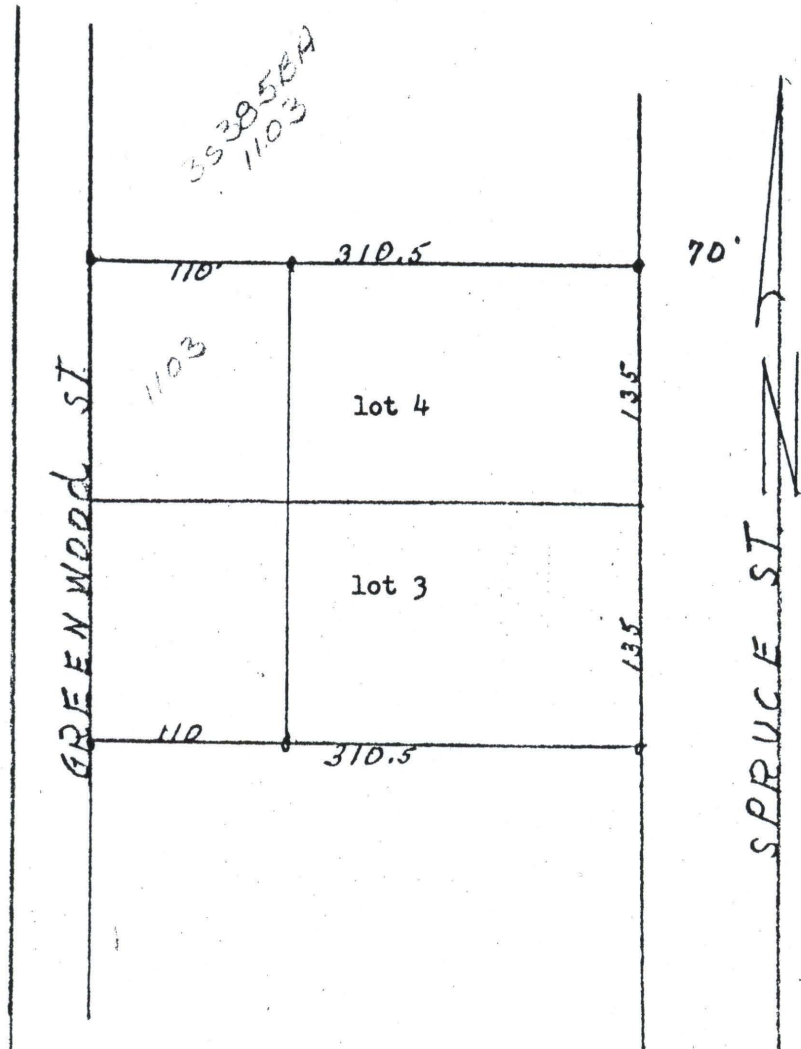

REGISTERED
OREGON
LAND SURVEYOR

James G. Voelz

MAY 4, 1956
JAMES G. VOELZ
381