


12-01
12-21

William R. Workman
608 Cedar St.
La Grande, Oregon.

12-21
Description: All of Lot #4 and east 5 feet of Lot #3 of Block 6
of Arnold & Dray's Addition to La Grande, Oregon.

Date April 17, 1967

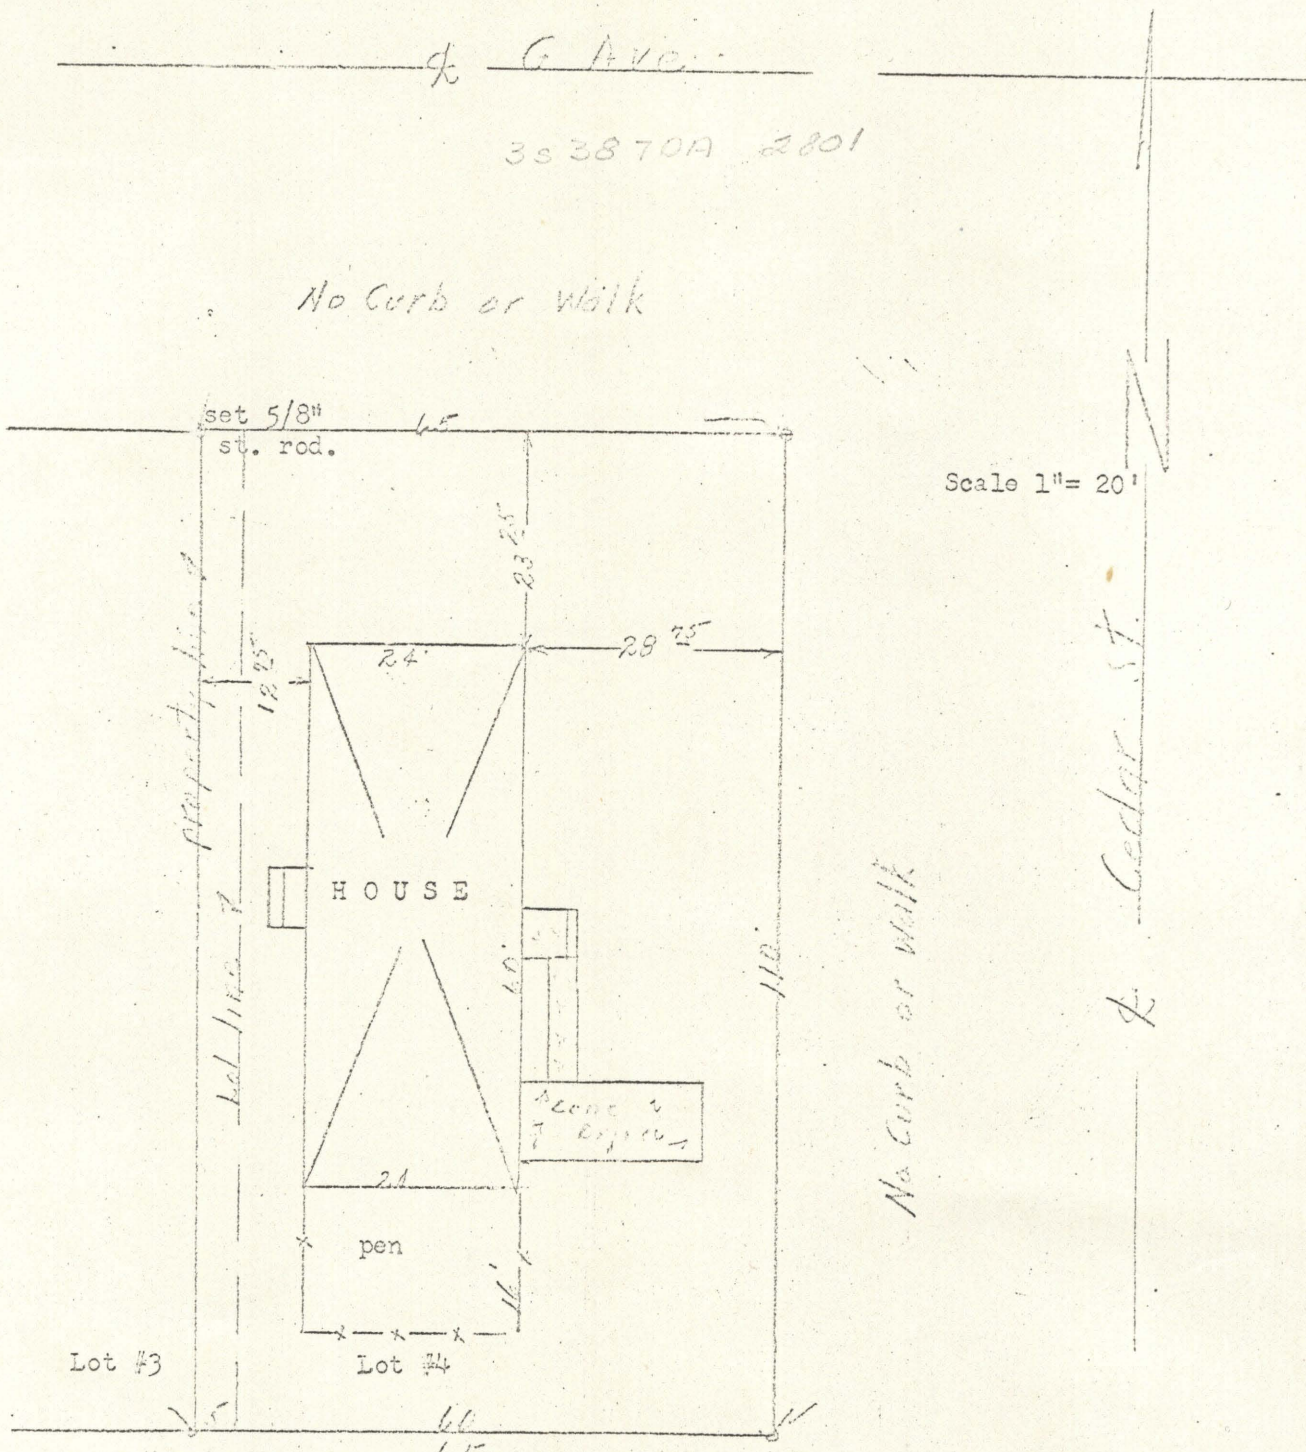

Scale 1" = 20'

I certify I did not find any encroachments onto or off of described property.

REGISTERED
OREGON
LAND SURVEYOR
James G. Voehl
MAY 2, 1963
JAMES G. VOELZ
281