


1A-67

Lg-71

Ed Johnson
604 F.
La Grande, Oregon

333870A 7100

May 15, 1967

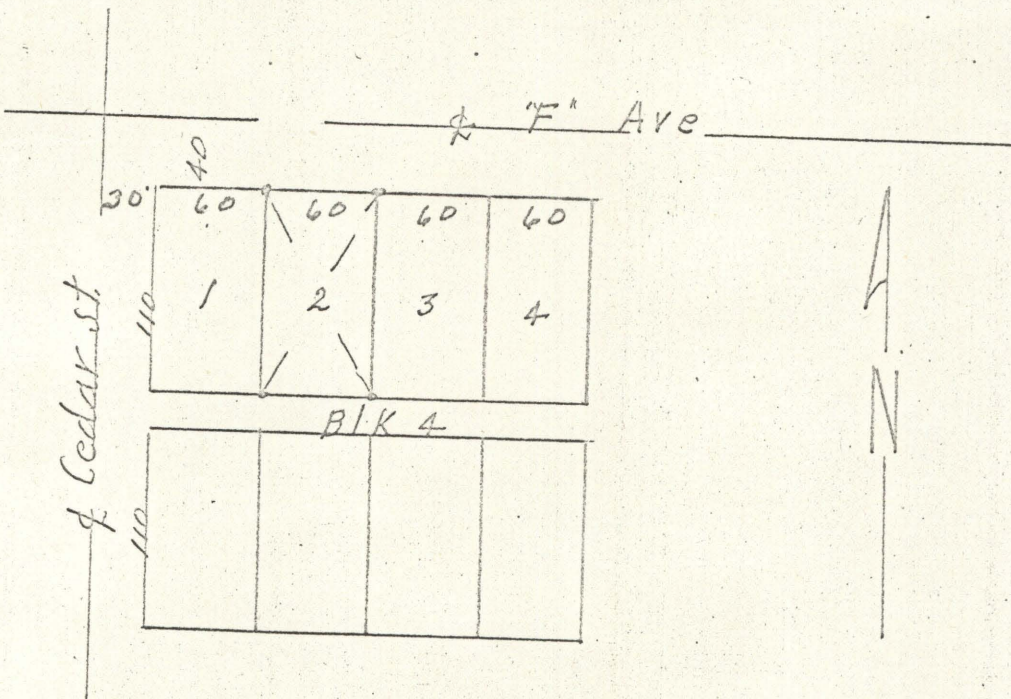

Description;
Lot 2 of Block 4 of Arnold and Dray's Addition to La Grande, Oregon

REGISTERED
OREGON
LAND SURVEYOR

James G. Voelz

MAY 4, 1956
JAMES G. VOELZ
381