

15-67


19-51

Terry Lincoln
604 Sunset Drive
La Grande, Oregon

Date, April 2, 1967

Description; The north 10 feet of lot 30 and lot 29 except the north and west 10 ft. ; of Modelaire Heights Addition to La Grande, Oregon.

35 38 7DB

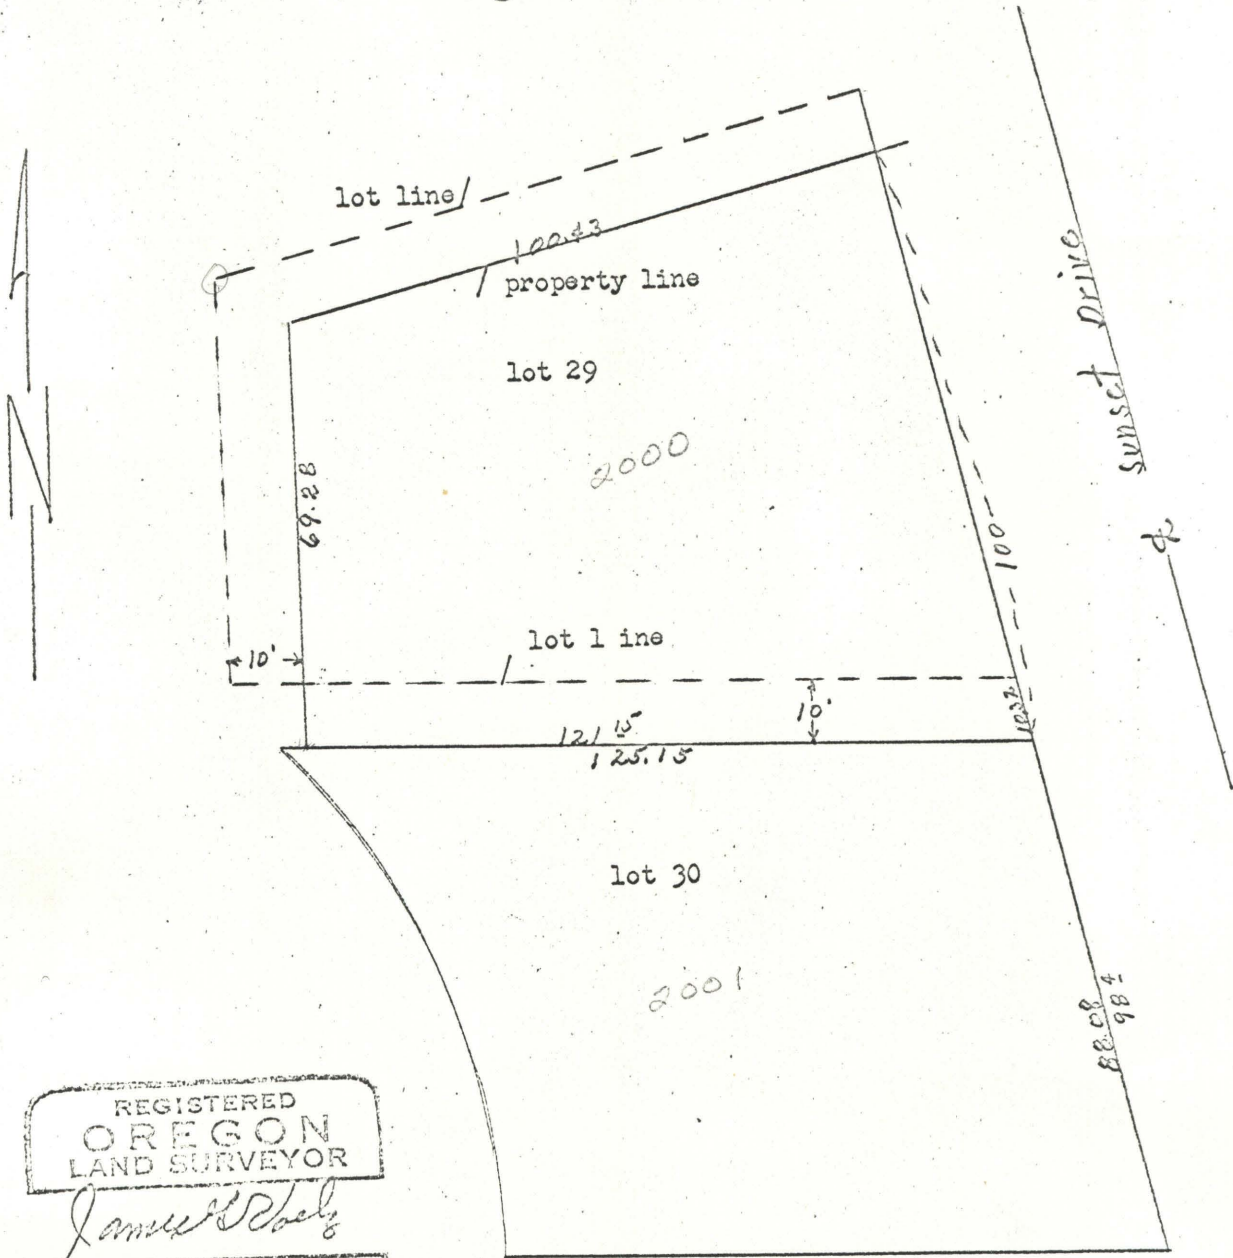

REGISTERED
OREGON
LAND SURVEYOR

James G. Voelz

MAY 4, 1959
JAMES G. VOELZ
381