

16-67

L9-91


2 Filed

Wm. Lovan
506-1/2 B Avenue
La Grande, Oregon

May 10, 1967

Description: The west 70 feet of Lot 11 and 12 of Block 14 of
Arnold's Addition to La Grande, Oregon

3538700
220092201

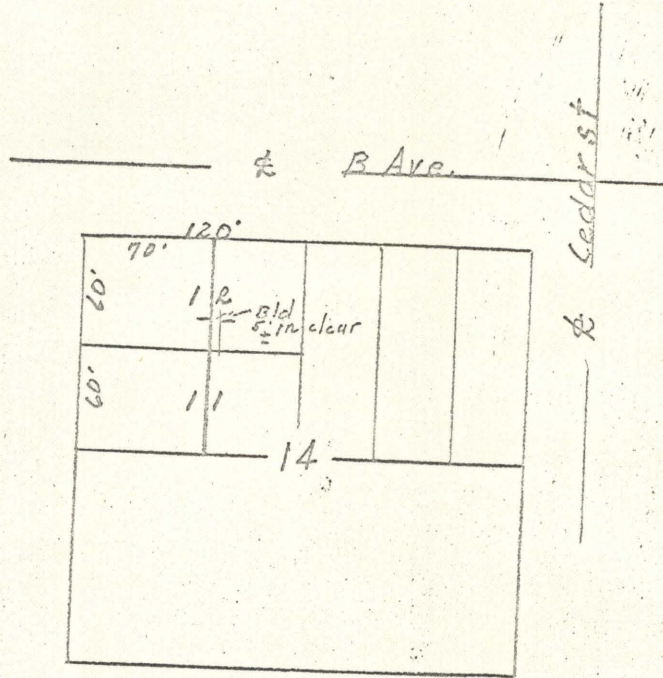

Scale 1"=100'

REGISTERED
OREGON
LAND SURVEYOR

James G. Voelz

MAY 4 1966
JAMES G. VOELZ
SS1