

Jesse M. & Rosabell L. Vermillion
Island City, Oregon


33383AB 600

September 22, 1967

Description:

All of lot 2, the north 30 feet of lot 3, the west 40 feet of lot 7 and the west 40 feet of the north 30 feet of lot 6 of Block 2 of the Town of Island City, Oregon.

scale 1" = 20'

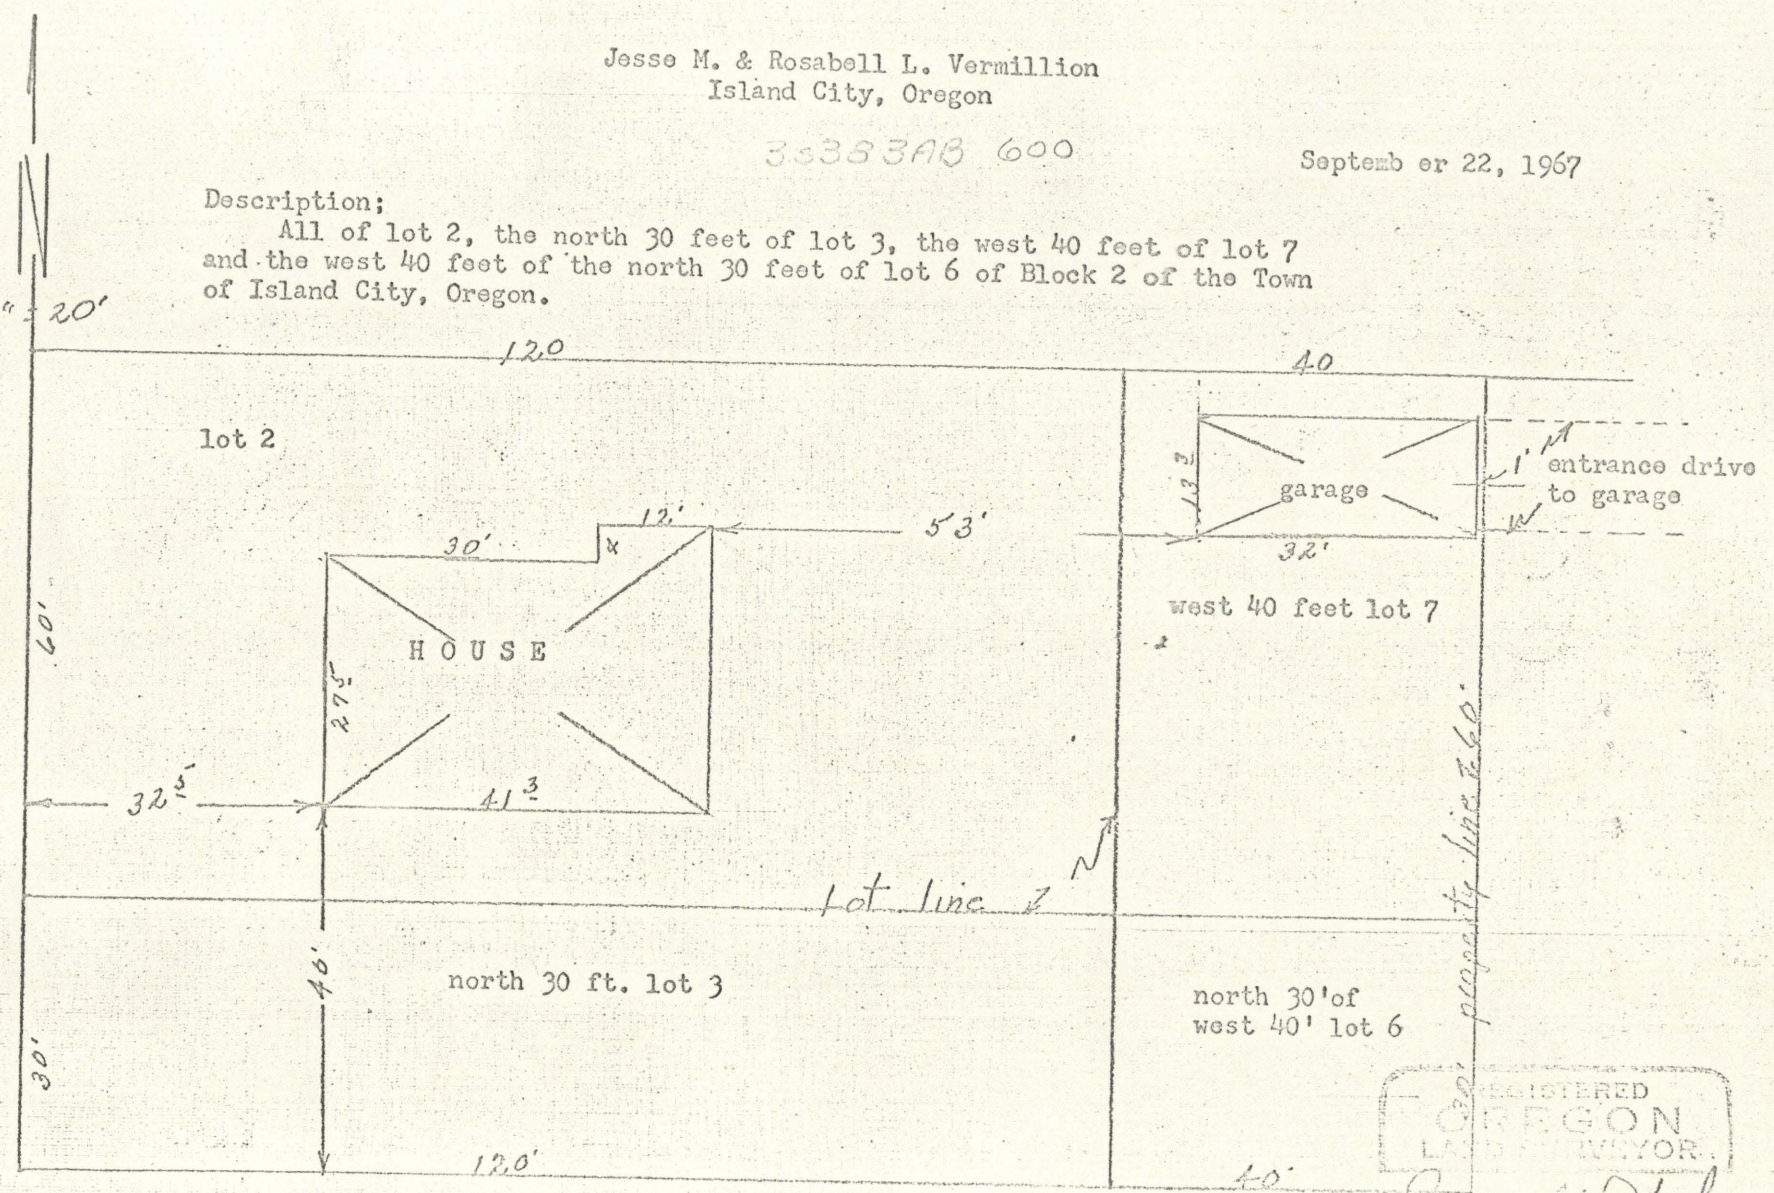

22-67

Main St

REGISTERED
OREGON
LAND SURVEYOR

James P. Deitz

MAY 11 1966
JAMES P. DEITZ

I certify I did not find any encroachments onto or off of described property except as shown.

22-67