


23-67

23-67

Ralph Jones
Island City Highway
La Grande, Oregon

March 14, 1967

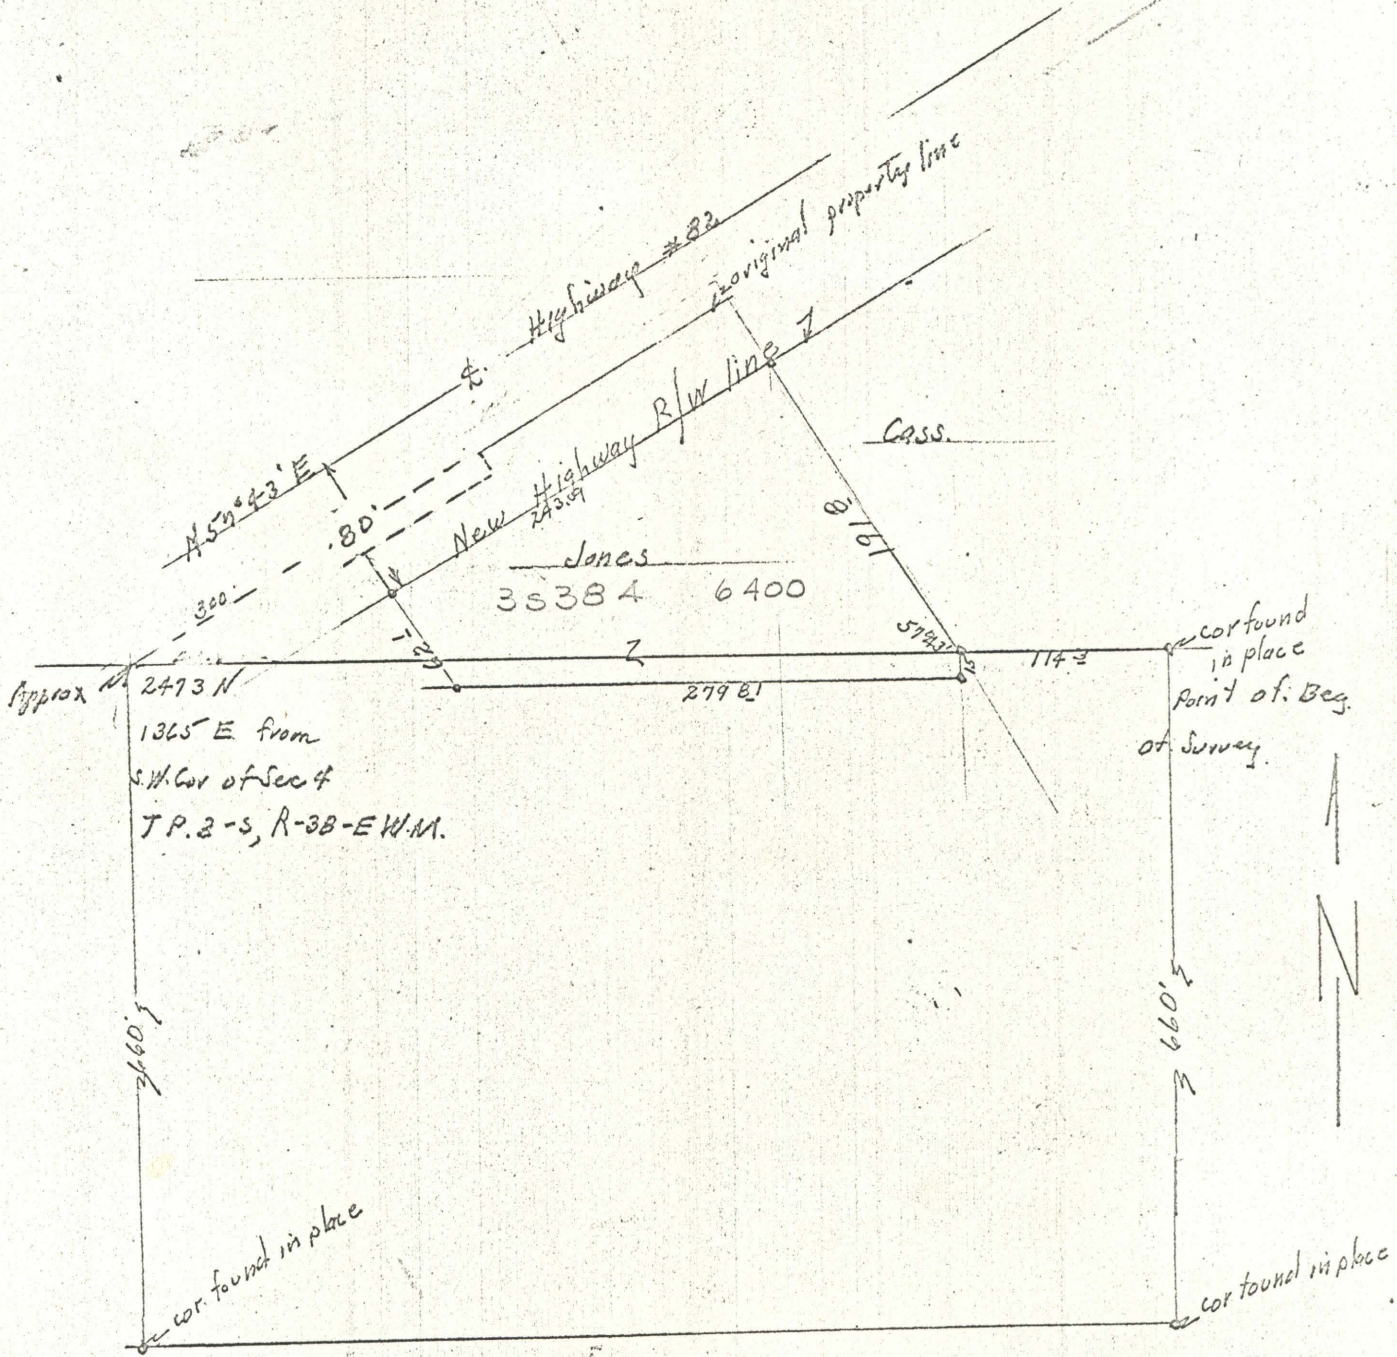

REGISTERED
OREGON
LAND SURVEYOR

James G. Voelz
MAY 4, 1953
JAMES G. VOELZ
381