

27-67

L9-L2


W.H. Miller  
2611 3rd. St.  
La Grande, Oregon

July 25, 1967

Description;

Lots 9, 10, 11, and 12 of block 6 of Riverside Addition to  
La Grande, Oregon.

scale 1" = 100'

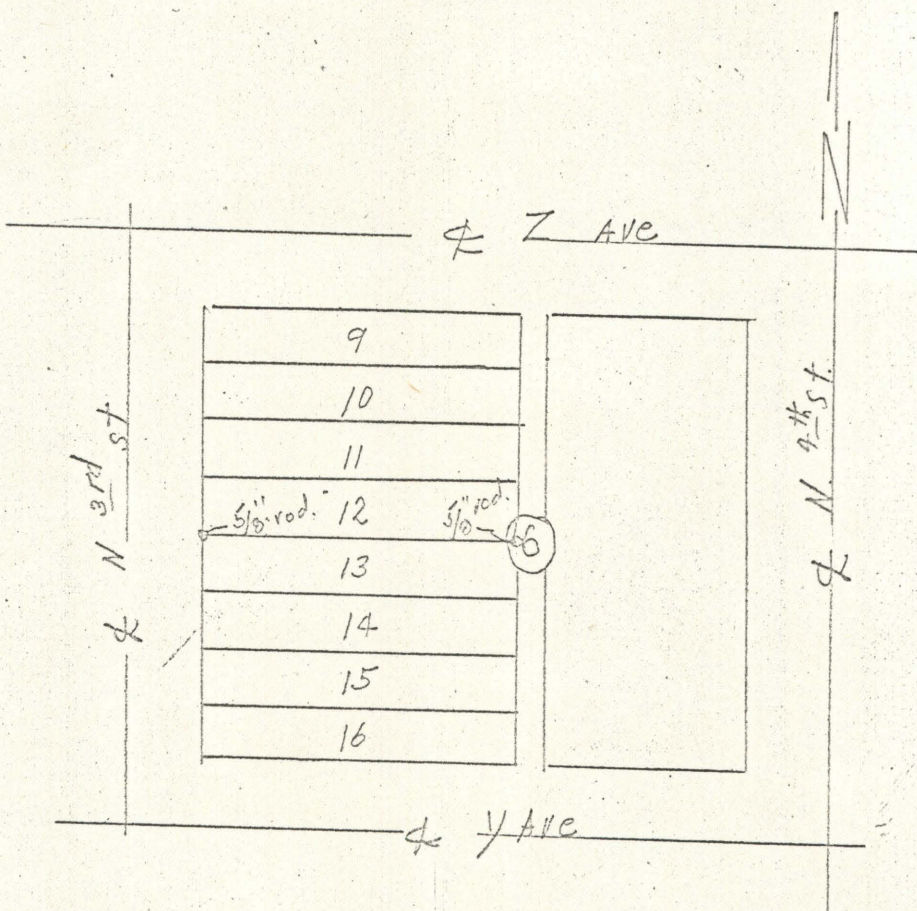

3 38 6 AD  
400

REGISTERED  
OREGON  
LAND SURVEYOR  
*James G. Voelz*  
MAY 4, 1958  
JAMES G. VOELZ  
381