L9-18

31-67

Fred F. Hildebrandt
1707 First Street
La Grande, Oregon

Date- Jan 19, 1967

Description; The south 48 ft. of the west 60 ft and the south 20 ft. of the east 50 ft. of lot 7 of Block 13 of Grandy's Addition to La Grande, oregon.

3 3860D 10100

Scale 1"= 20'

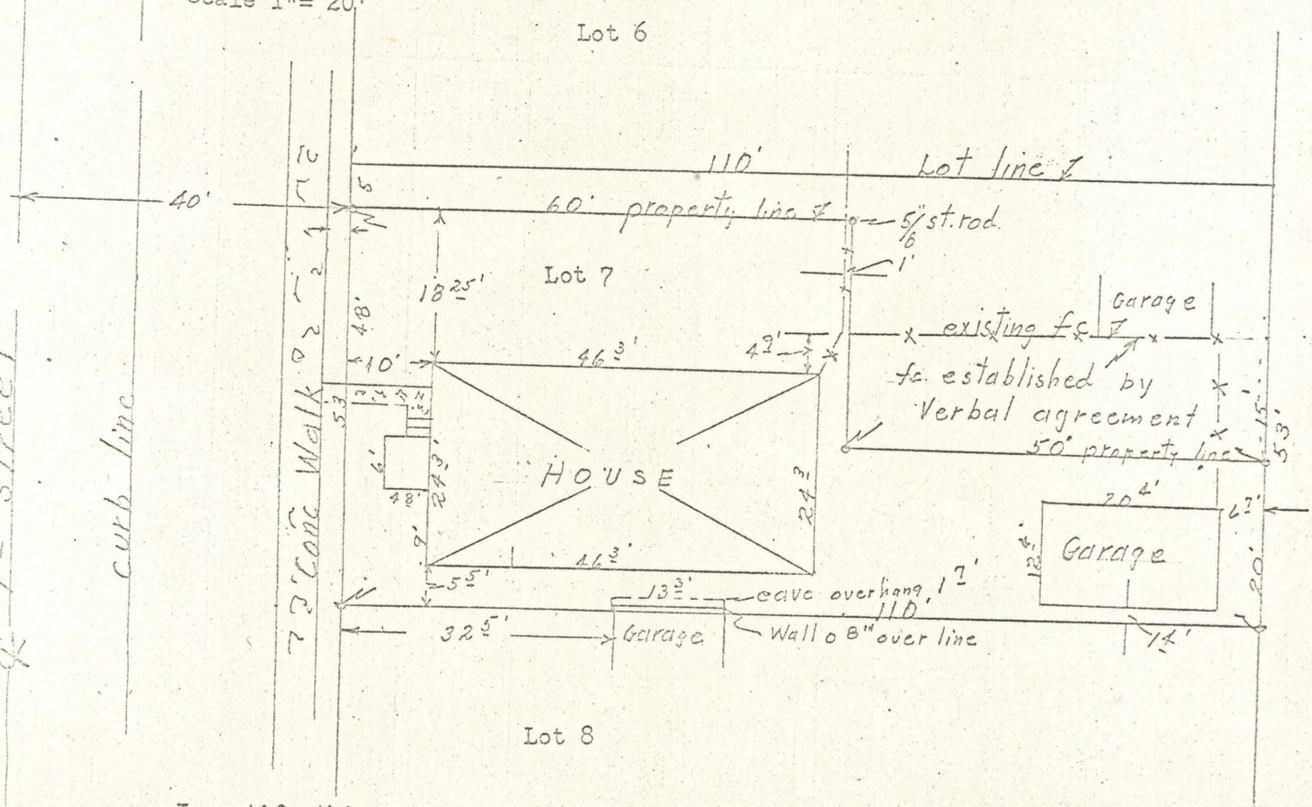

I certify this survey was completed by me and Jan. 19, 1967 and apparent encroachments are as shown.

REGISTERED
OREGON
LAND SURVEYOR

James G. Voelz

MAY 4, 1960
JAMES G. VOELZ
387