


L9-4E

34-67

William R. Workman
608 Cedar St.
La Grande, Oregon.

Description: All of Lot #4 and east 5 feet of Lot #3 of Block 6
of Arnold & Dray's Addition to La Grande, Oregon.

Date April 17, 1967

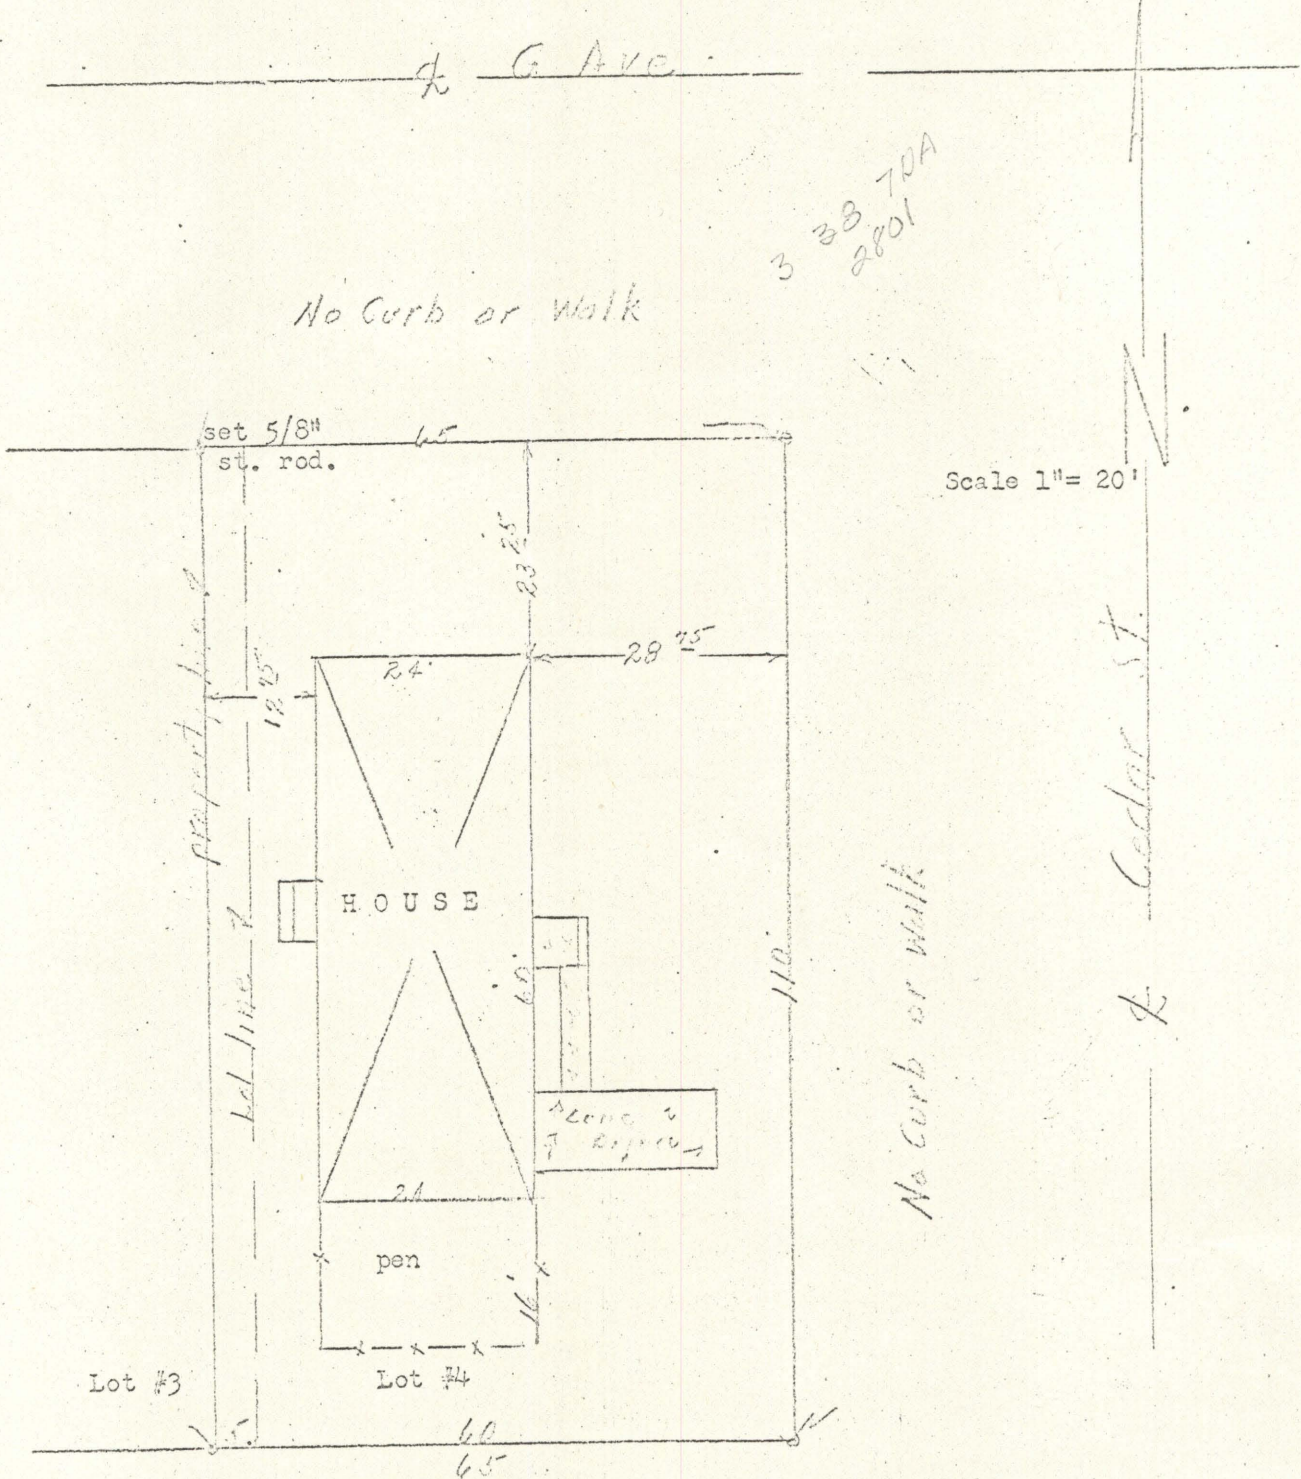

I certify I did not find any encroachments onto or off of described property.

REGISTERED
OREGON
LAND SURVEYOR

James G. Votiz

MAY 4, 1968
JAMES G. VOTIZ
281