


L9-8E

Warren Arnson
2816 2nd. St.
La Grande, Oregon

October 23, 1967

Description: Lot 4 of Block 2A of the original town of Le Grand,
Union County, Oregon.

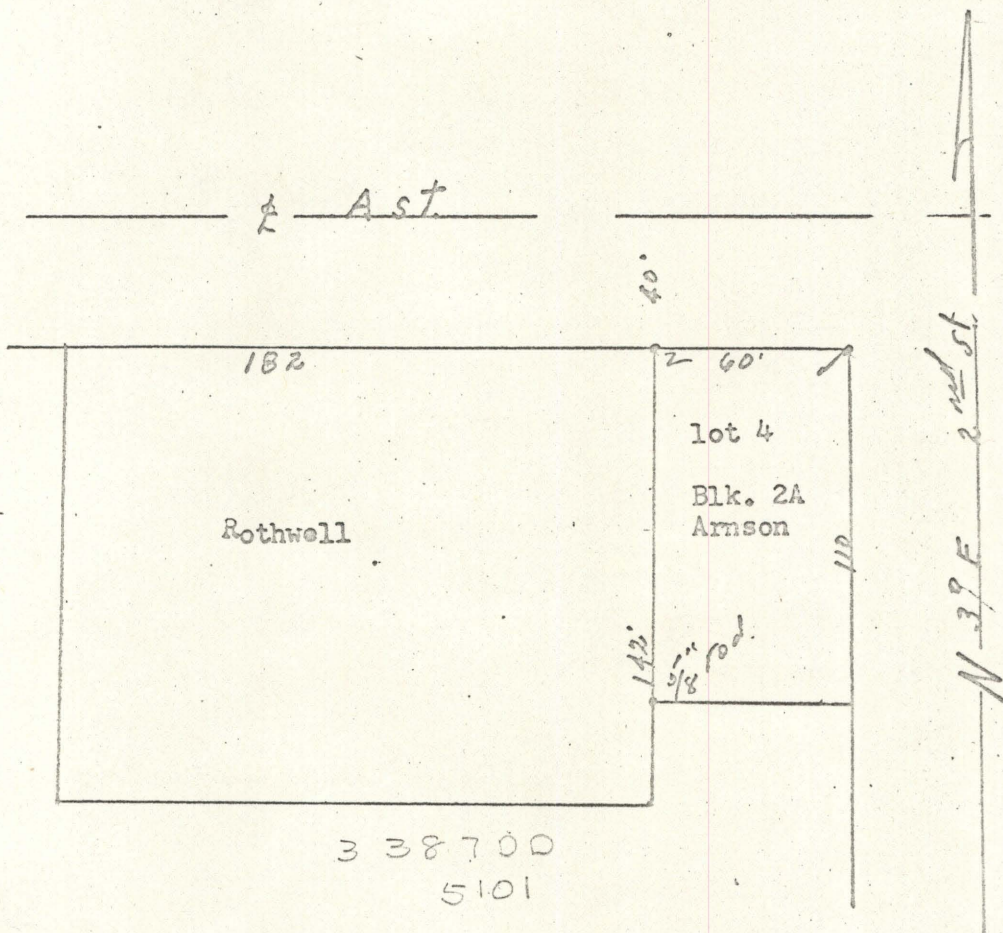

REGISTERED
OREGON
LAND SURVEYOR

James G. Voelz

MAY 4, 1953
JAMES G. VOELZ
381