


468

Merle Burling  
Fruitdale  
La Grande, Oregon

March 5, 1968

scale 400' = 1"

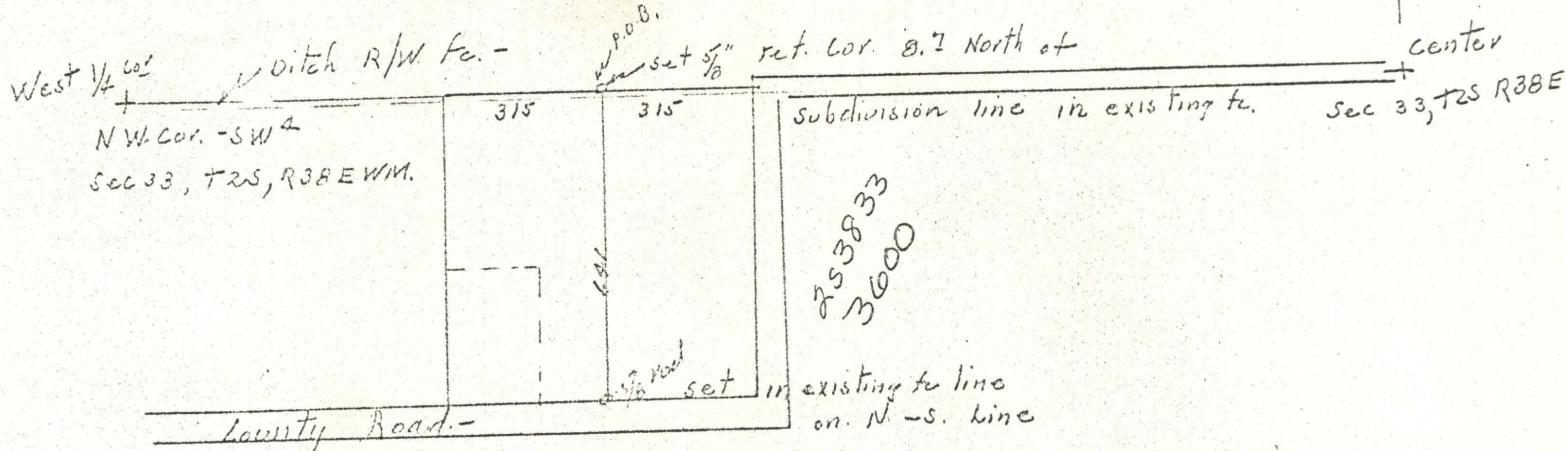

Commencing at a point 59 rods,  $1\frac{1}{2}$  feet (975) east of the northwest corner of the southwest quarter of Section 33, in Township 2 South, R38EWM; running thence east 19 rods  $1\frac{1}{2}$  feet (315 feet); thence south 38 rods and 13 feet (640); thence west along the north line of the east-west county road, a distance of 19 rods  $1\frac{1}{2}$  feet (315) feet; thence north 38 rods and 13 feet (640) to point of beginning.

Situate in the northwest quarter of southwest quarter of section 33, In T2S, R38EWM, in Union county, Oregon.

