


Survey for Frank Nims  
Cove Oregon

March 1968

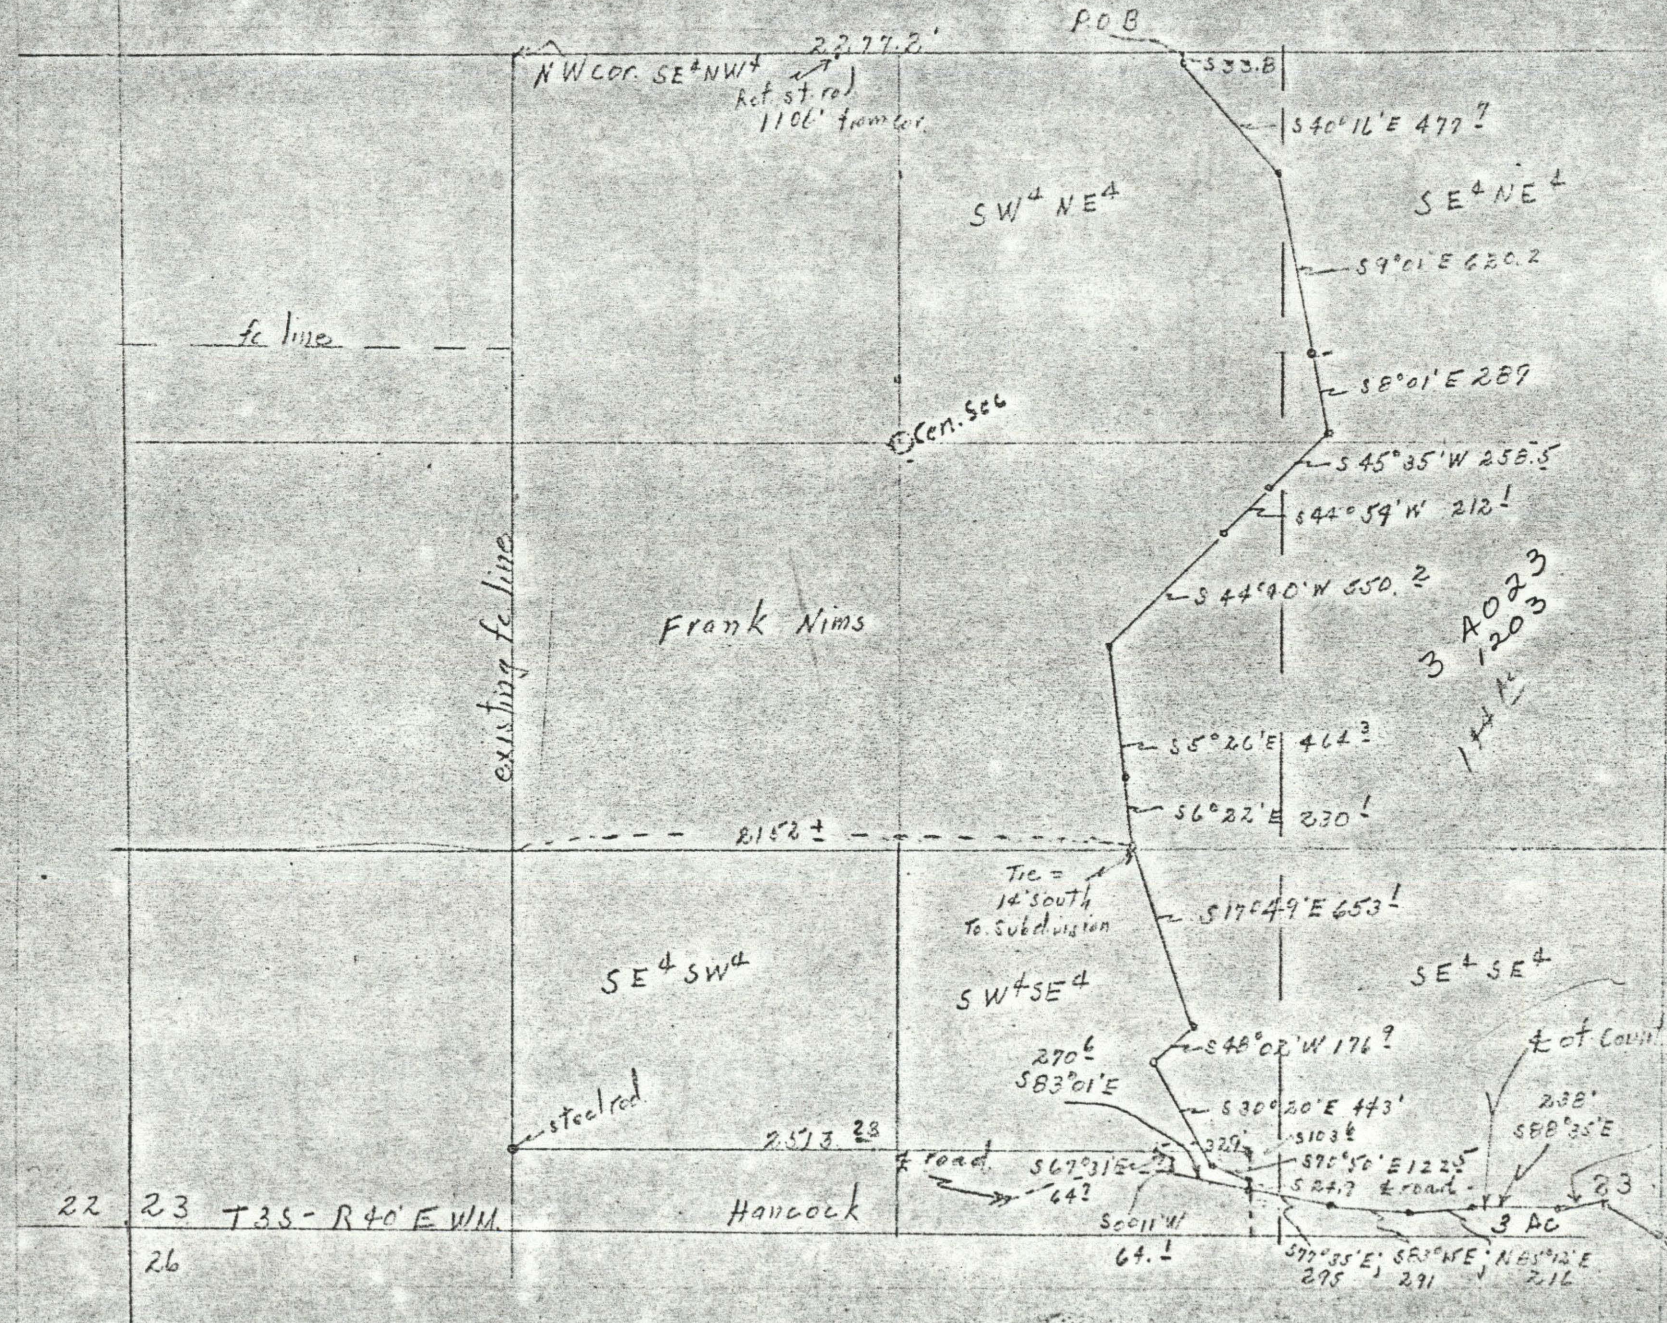

Scale 1"=660'

REGISTERED  
OREGON  
LAND SURVEYOR

James G. Vollen

MAY 4, 1966  
JAMES G. VOLLEN  
301

89-7-68