


Ronde Valley Lumber Co.
Union, Oregon

Feb. 20, 1968

Description:
Block 4 and 5 of Union, Union County, Oregon

As 4019BA

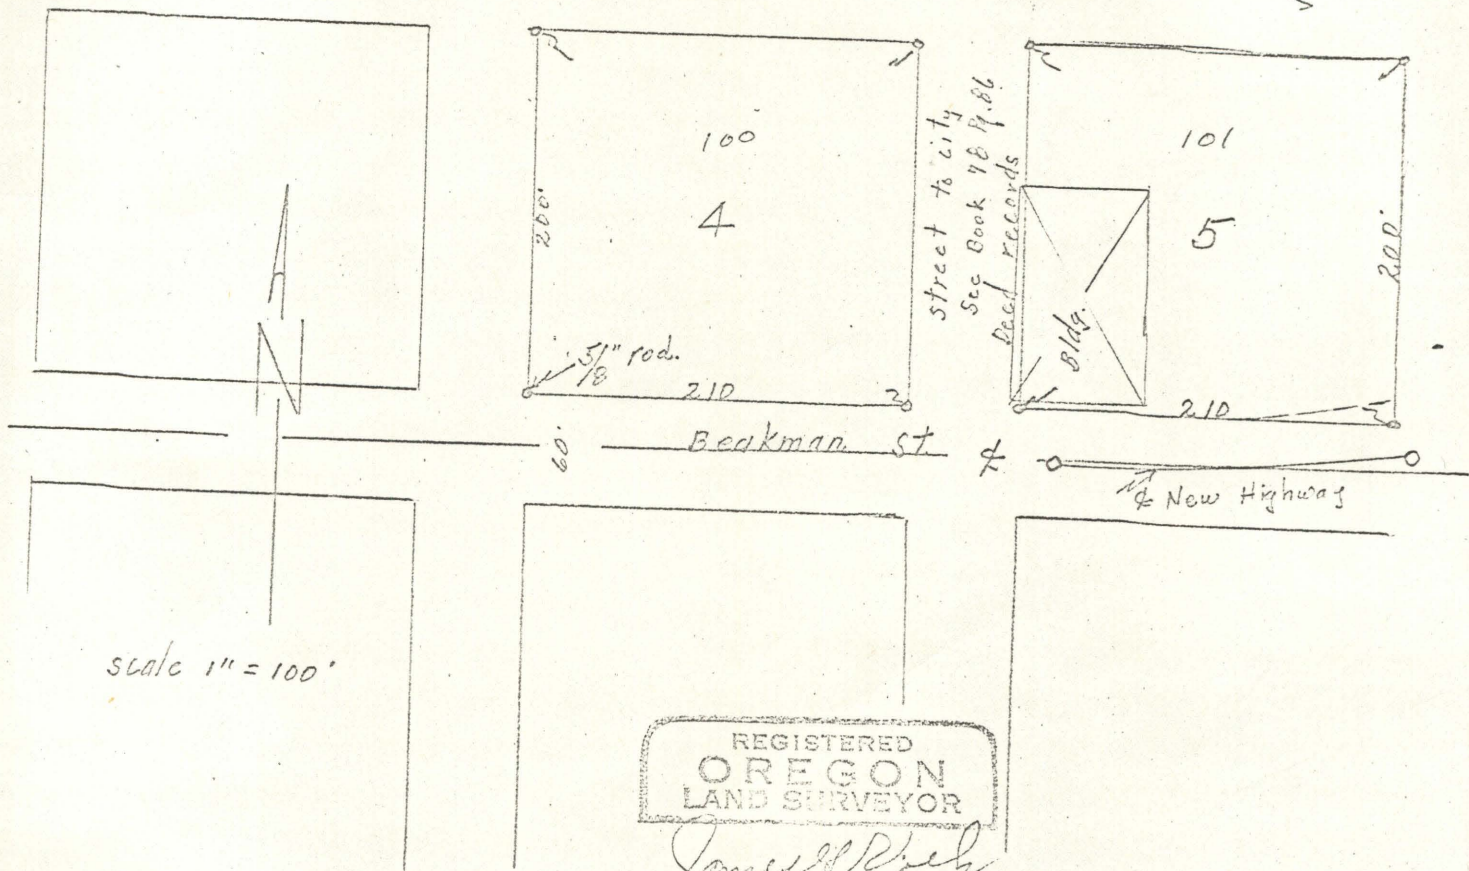

REGISTERED
OREGON
 LAND SURVEYOR
James G. Voelzi
 MAY 4, 1956
JAMES G. VOELZI
 381