

89-81

89-81


89-81

Guy Pebley
804 Washington Ave.
La Grande, Oregon

Feb 26, 1968

Description;

The east 66 feet of lots 6 and 7 of Block 9 of Grandy's
Addition to La Grande, Oregon.

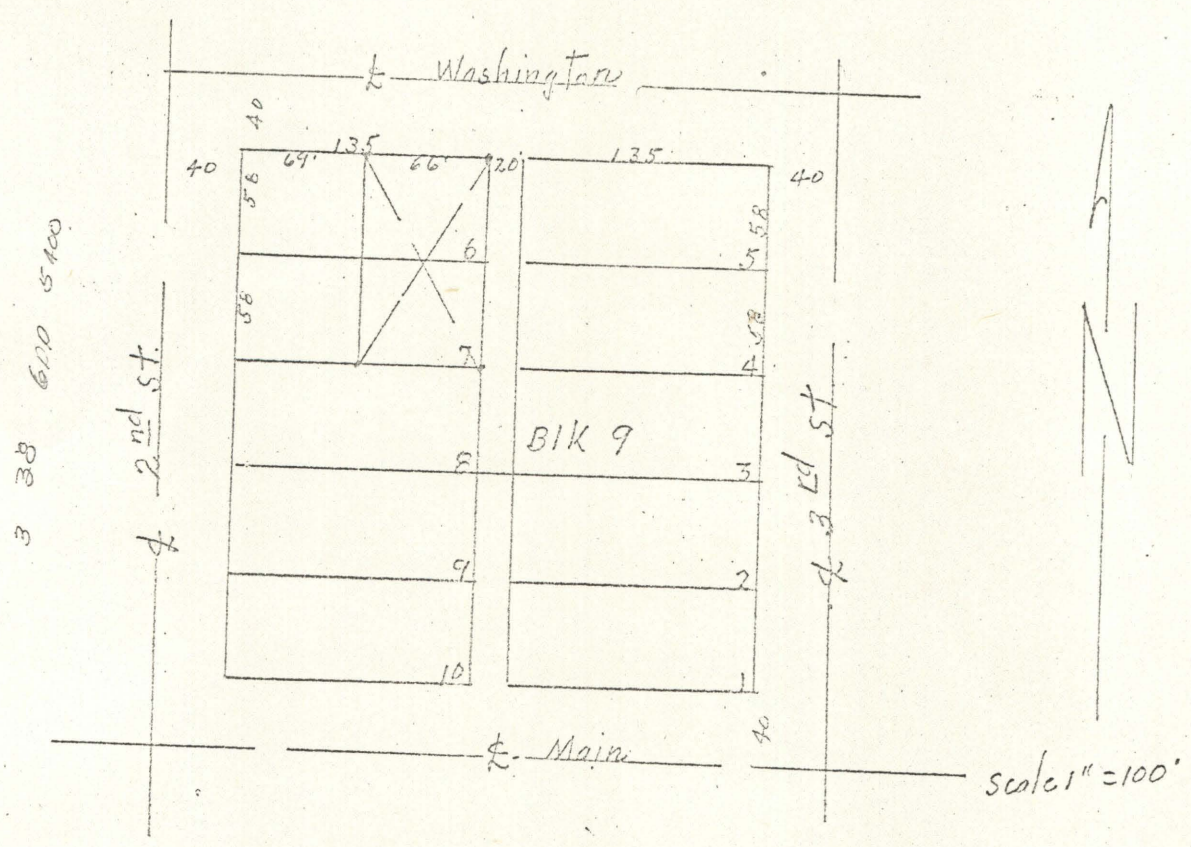

REGISTERED
OREGON
 LAND SURVEYOR

James G. Vohle

MAY 4, 1933
 JAMES G. VOHLE
 331

89-81