


89-61

89-61

Teddy M. & Beverly K. Clausen  
1508 T, Avenue  
La Grande, Oregon

Feb. 25, 1968

Description: Lots 3, 4, & 5 of Block 152 of Chaplin's Addition  
to La Grande, Oregon.

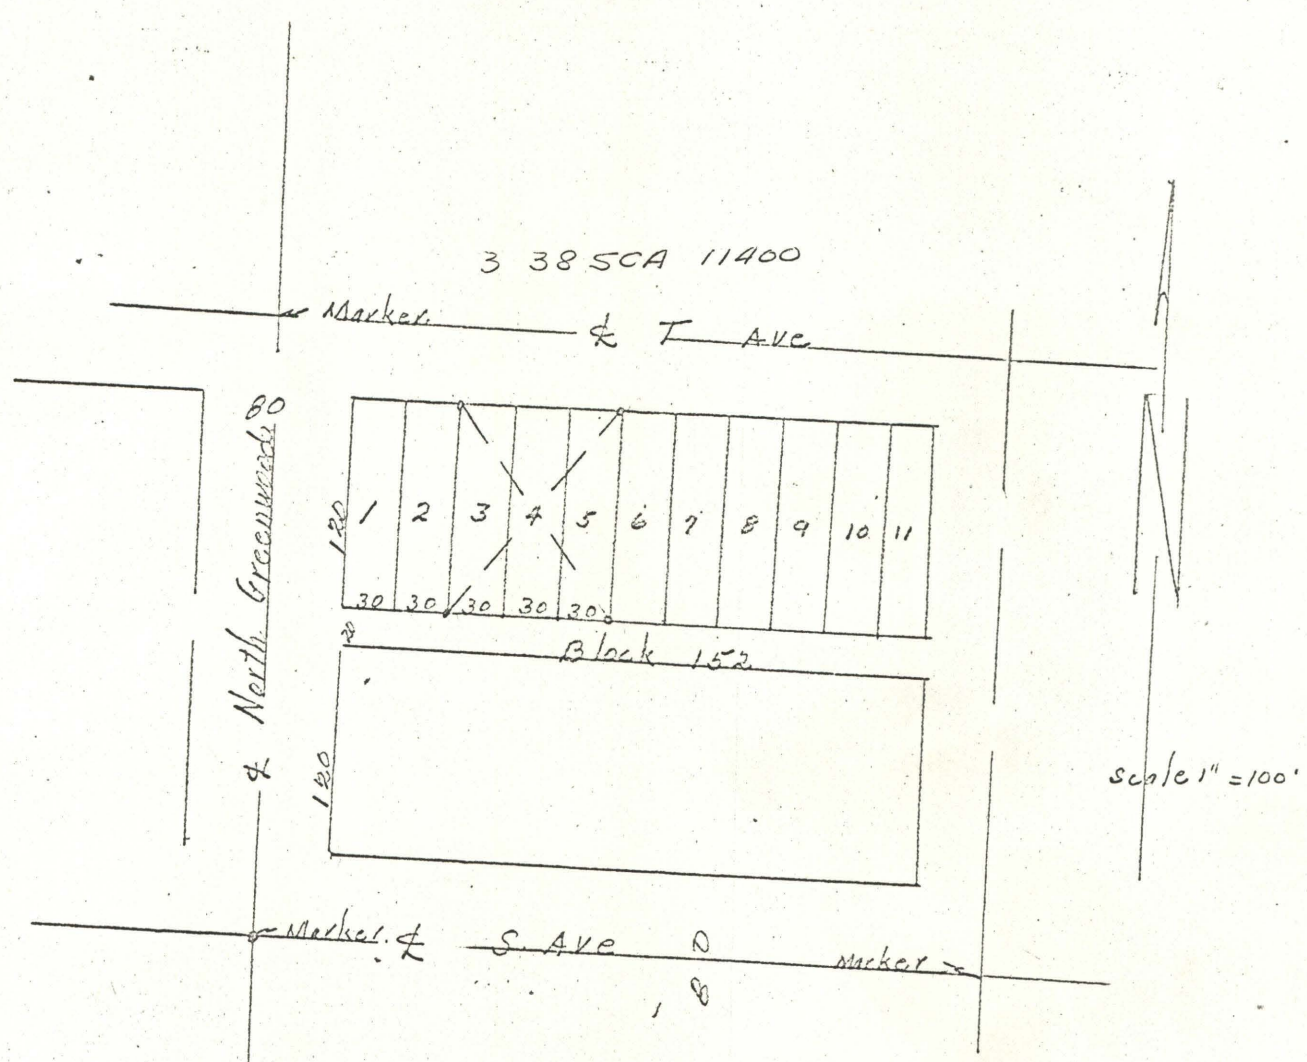

REGISTERED  
OREGON  
LAND SURVEYOR

*James G. Voelz*

MAY 4, 1955  
JAMES G. VOELZ  
381

252  
23  
229