


89-42

Ken Moody  
Rt. #1 Box 14  
La Grande, Oregon

March 16, 1968

Description;  
Lots 4, 5, 6, 7, 8, 9, 10, and 11 of Block 46 of Riverside Addition to  
La Grande, Oregon.

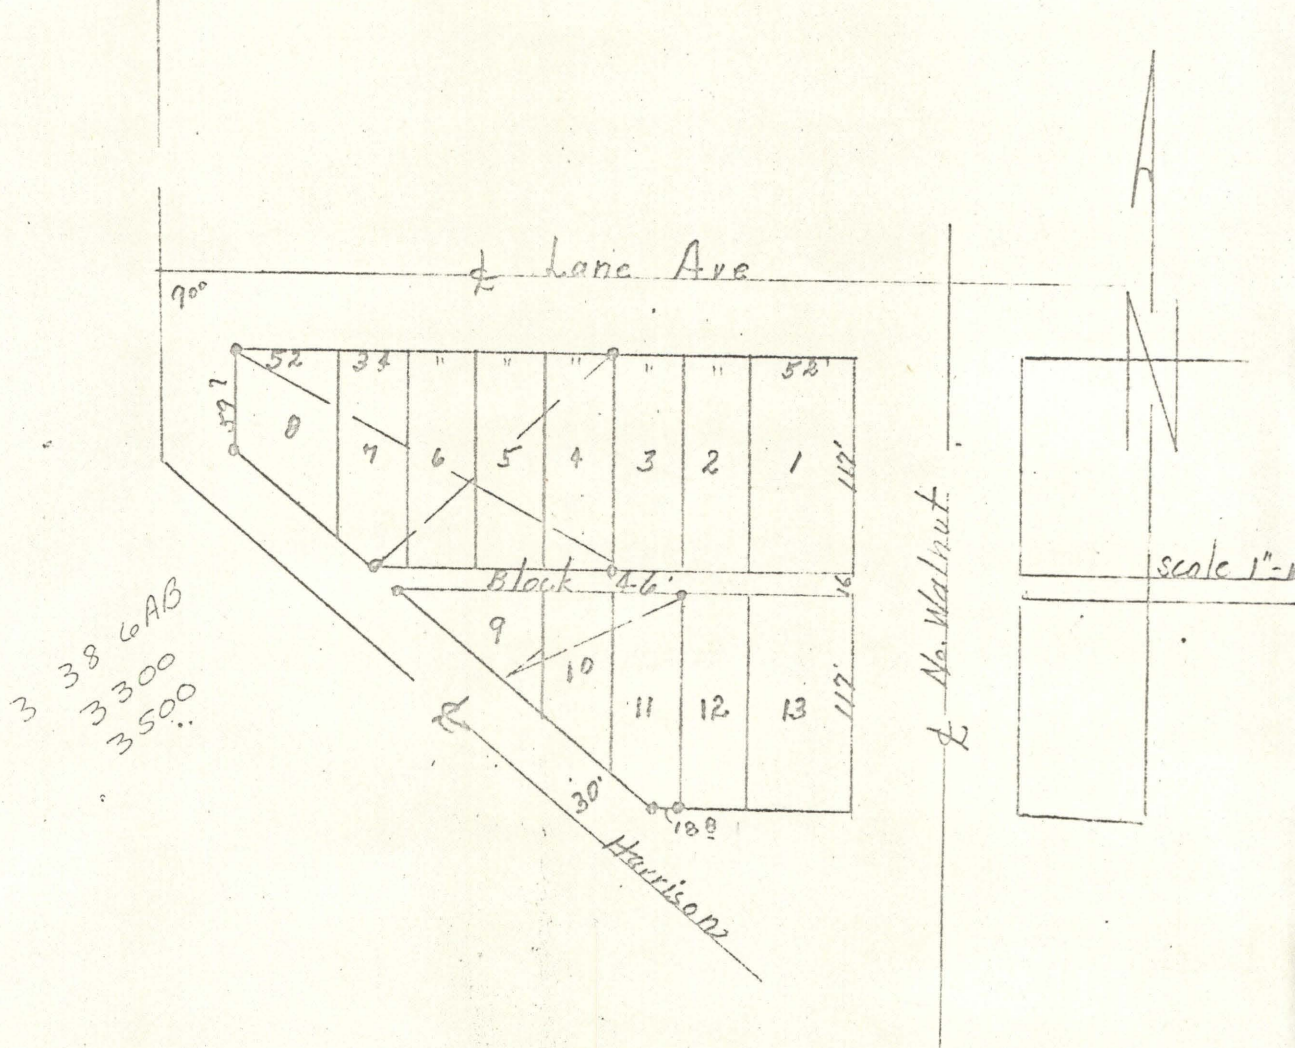

3 38 6AB  
3 300  
3 500

REGISTERED  
OREGON  
LAND SURVEYOR

*James G. Voelz*

MAY 4, 1956  
JAMES G. VOELZ  
381