

27-68


89-12

J.O. Ramsey
604, Lane Ave.
La Grande, Oregon

Feb. 4, 1968

Description;

The west one half of Block 26 of Riverside Addition to La Grande, Oregon.

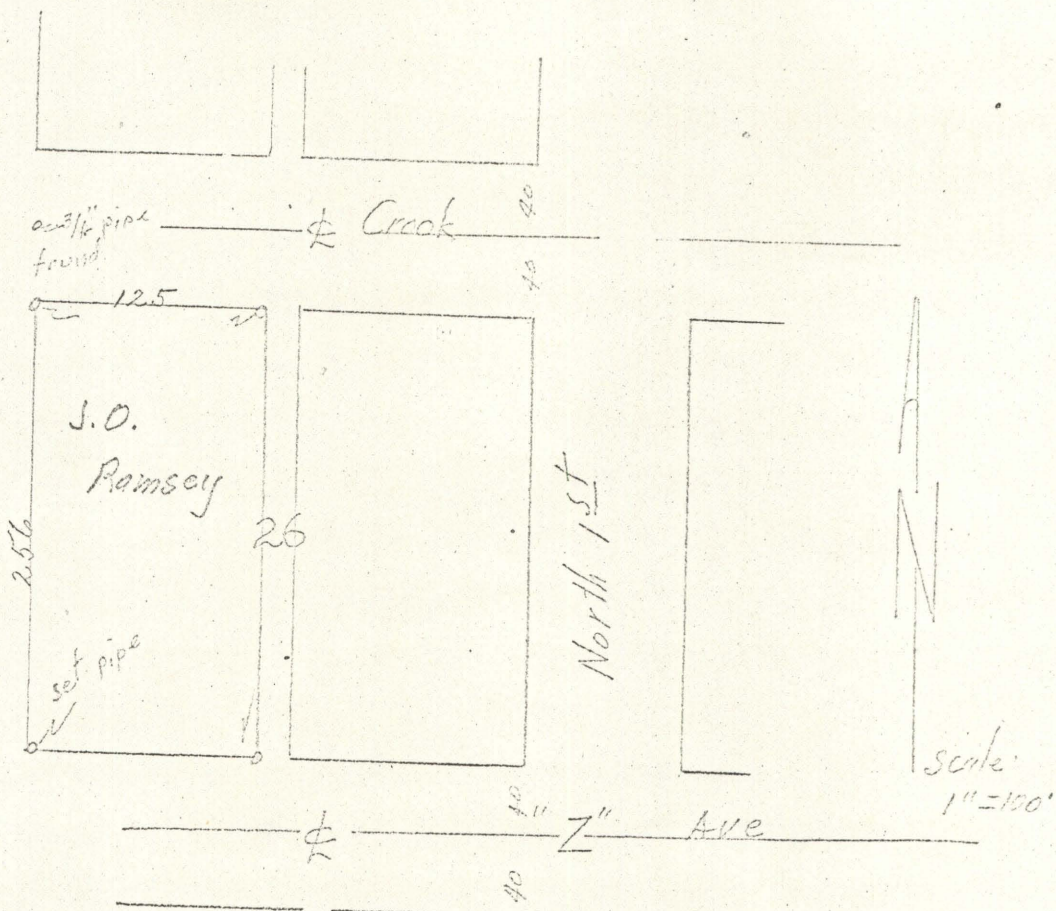

3 386 AA
6900, 6901, 6902

