


89-82

Gus Tsiatsos
407 3rd St.
La Grande, Oregon

Feb 3, 1968

Commencing at a point on the south line of Block 5 in ARNOLD'S ADDITION to La Grande, Union County, Oregon, which is 150 feet East 3° South from the southwest corner of said Block 5; thence North 3° East 240 ; Thence South 87° East 169.35 feet to east line of said Block 5; thence southerly and on east line of said Block 5, 240 feet to the south east corner of Block 5; thence North 87° West 180.5 feet to point of beginning.

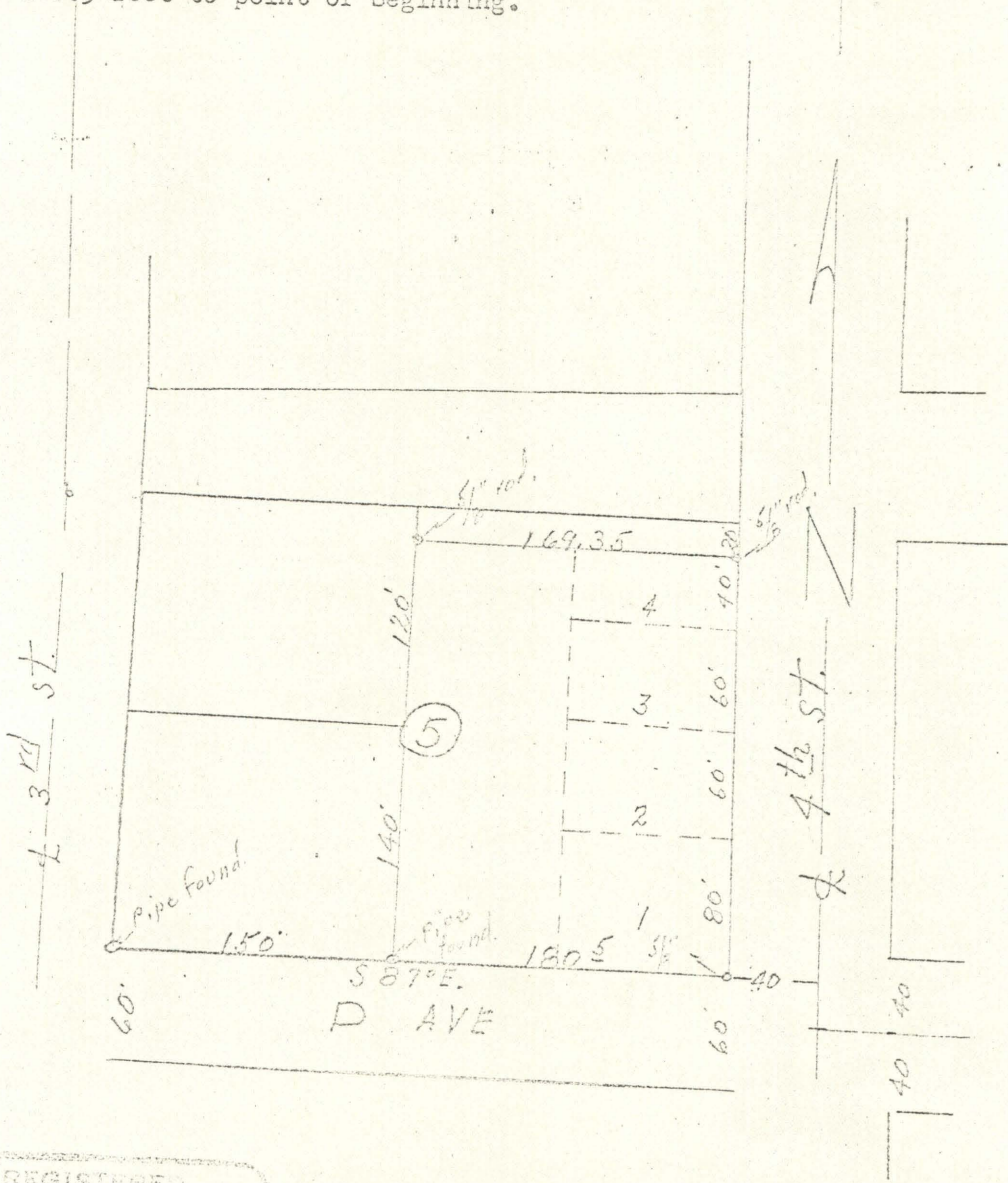

REGISTERED
OREGON
LAND SURVEYOR

James G. Voelz

MAY 4, 1935
JAMES G. VOELZ
301