


89-03

Mrs. H. D. Wilson
1823 Z. Ave.
La Grande, Oregon

March 26, 1968

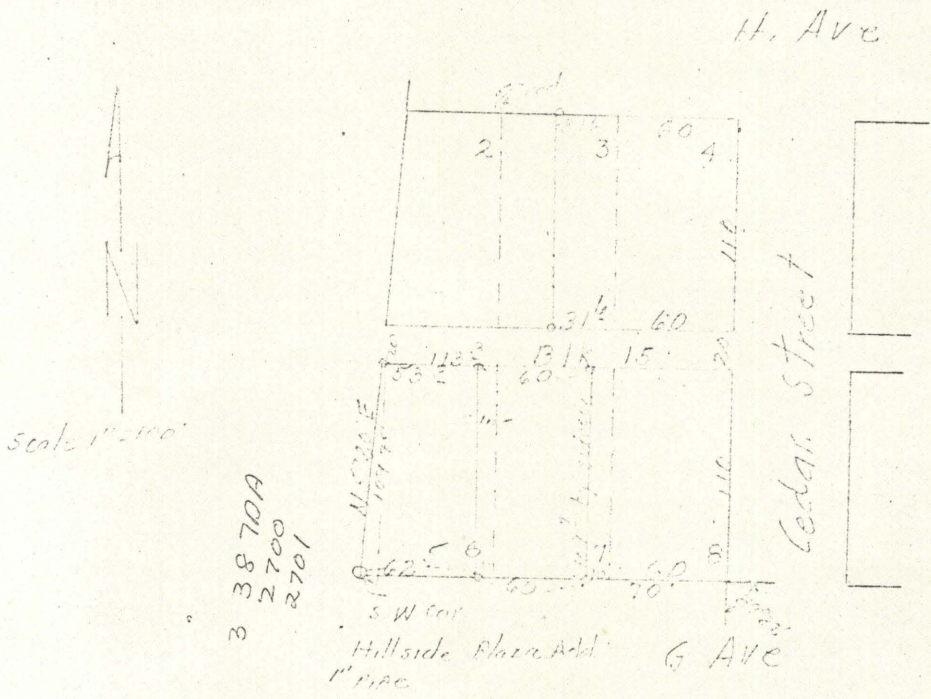

Description;

The east 10 feet of Lot 6 and the west 50 ft. of Lot 7 of Block 15 of Arnold and Dray's Addition to La Grande, Oregon.

The west 50 feet of Lot 6 of Block 15 of Arnold and Dray's Addition to La Grande, Oregon
Also starting at the Southwest corner of lot 6 of Block 15 of Arnold and Dray's Addition to La Grande, Oregon; thence west on the north side of "G" Avenue 12.5 feet more or less to the south east corner of Hillside Plaza Addition to La Grande, Oregon; thence N5°20'E on the east boundary of Hillside Plaza Addition to the south side of the Alley of Block 15; thence east on the north boundary of Lot 5 a distance of 3.3 feet more or less to northeast corner of Lot 5 Said block; thence south to southeast corner of Lot 5 Block 15 of Arnold and Dray's Addition to La Grande, Oregon

REGISTERED
 OREGON
 JAMES W. [Signature]
 [Faint text below signature]