


32-68

32-68

Hershel E. & Hally S. Hanby.
2312 Adams Avenue
La Grande, Oregon

Date. Nov 23, 1966

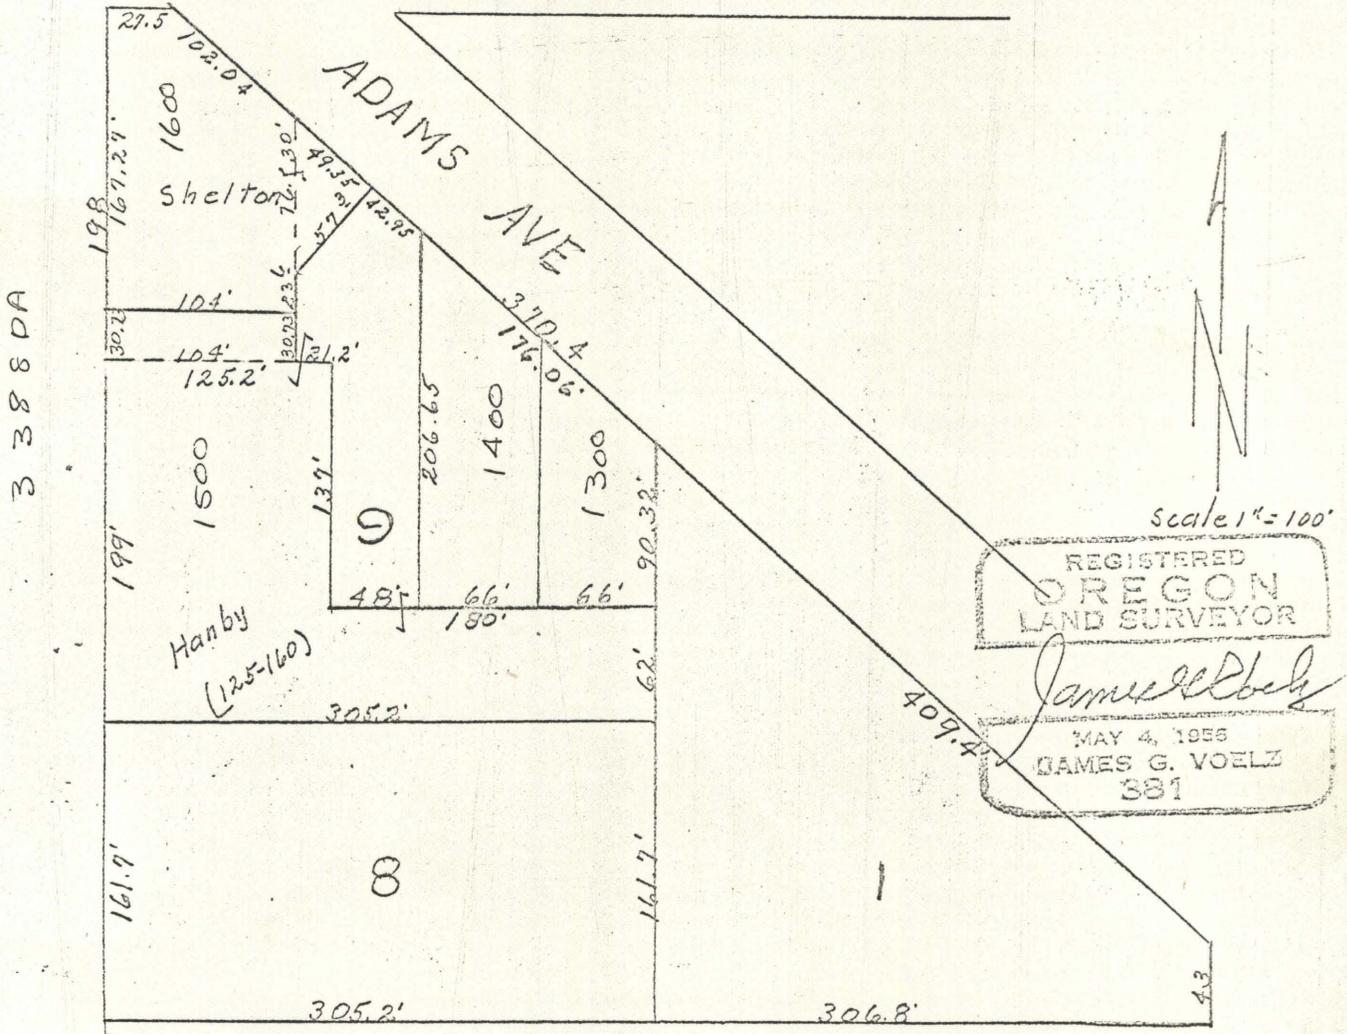

Hanby description; Commencing at a point 62 feet north and 132 feet west of the southeast corner of Tract 9, Highway Acres Subdivision, and running thence west parallel with the south line of said tract 9 a distance of 48 feet.; thence north parallel with the west line of said Tract 9 a distance of 137 feet; thence west parallel with the south line of said Tract 9 a distance of 21.2 feet; thence north parallel with the west line of said tract 9 a distance of 54.33 feet.; thence northeasterly 57.3 feet more or less to a point on the southwesterly line of Adams Ave. extended, said point being 219.01 feet from the northeasterly corner of said tract 9.; thence southeasterly on the southwesterly line of Adams Ave. extended 42.95 feet to a point which is north of the point of beginning. thence south to the point of beginning.

Being a part of tract (or lot) 9 of HIGHWAY ACRES SUBDIVISION, adjacent to La Grande, according to the recorded plat of said subdivision, and situated in the northeast quarter of southeast quarter of section 8, T3S, R38EWM, in Union County.

Shelton description; Beginning at the northwest corner of Tract 9 of Highway Acres Subdivision and running 27.5' on north boundary of said tract 9 to the southwesterly line of Adams Ave. Extended.; thence on the southwesterly line of Adams Ave. extended 151.39 feet more or less to the north corner of land conveyed to Hershel E. & Hally S. Hanby; thence southwesterly 57.3 feet more or less to a point which is 104 feet east and 143.67 feet south of point of beginning.; thence south parallel with the west line of said tract 9 a distance of 23.6 feet.; thence west 104 feet to the west line of said tract 9.; thence north to the point of beginning.

Being a part of tract (or lot) 9 of HIGHWAY ACRES SUBDIVISION, adjacent to La Grande, according to the recorded plat of said subdivision, and situated in the northeast quarter of southeast quarter of section 8, T3S, R38EWM, in Union County.

sheet #2 of descriptions for survey of Hershel E. & Hally S. Hanby.

Commencing at the southeast corner of Tract (or lot) 9 of HIGHWAY ACRES SUBDIVISION, and running thence north 62 feet; thence west parallel with the south line of said tract 9 a distance of 180 feet.; thence due north 137 feet.; thence west parallel with south line of said tract 9; 21.2 feet.; thence north parallel with west line of said tract 9, a distance of 30.73 feet. thence west parallel with south line of said tract 9 a distance of 104 feet.; thence south on the west line of said tract 9 a distance of 229.73 feet to the southwest corner of said tract 9.; thence east 305.2 feet to the point of beginning.

Being a part of tract (or lot) 9 of HIGHWAY ACRES SUBDIVISION, adjacent to La Grande, according to the recorded plat of said subdivision, and situated in the northeast quarter of southeast quarter of section 8, T3S, R38EWM, in Union County.